


WAR DEPARTMENT

CORPS OF ENGINEERS, U.S. ARMY

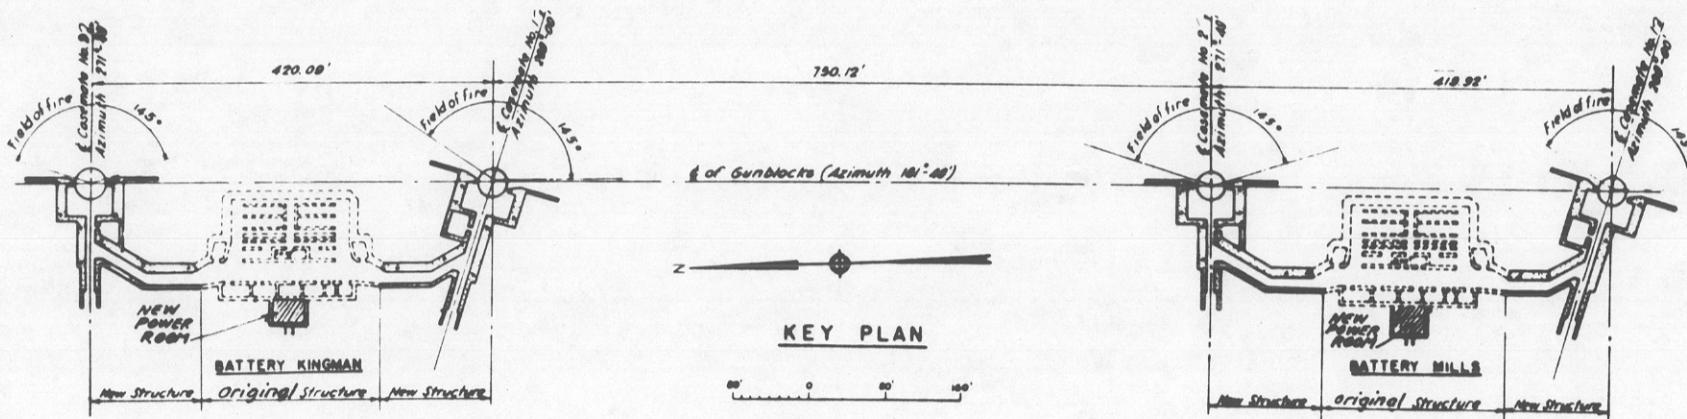

HARBOR DEFENSES OF NEW YORK

**BATTERY MILLS
CASEMATES & POWER ROOM**

FT. HANCOCK

NEW JERSEY

REPORT OF COMPLETED WORKS - SEACOAST FORTIFICATIONS
(Electric Plants)

COAST DEFENSES OF SANDY HOOK
FORT HANCOCK, N.J.
POWER FOR Kingman and Mills.
(Mills Battery)

Form 5.

Corrected to September 28, 1921.

	Serial No.	Type	Size	Mfr.	Date of transfer	Cost	Con-dition	Belt or Direct Drive	Radiator	Fuel or Engine	Switchboard Mate-	No. of Trial Panels
Boiler No. 1												
No. 2												
No. 3												
Engine No. 1	11207	SH 12	43 54 H.P.	G.E.	Mar. 31, 1921		New	560 "	Direct	"	"	Gasoline
No. 2	14476	" "	" "	"	" "		"	" "	"	"	"	"
No. 3												
Generator No. 1	449007	M. P.C. 6	25 K.W.	G.E.	Mar. 31, 1921	\$4,700.	New	560 "	Direct	"		
No. 2	679208	"	"	"	"		"	" "	"	"		
No. 3												
Radiator No. 1	10501	F.F. 54		G.E.	Mar. 31, 1921		New				11207	
No. 2	14873	"		"	"		"				14476	
(Fan No. 3)												
Motor-Generator	688557	C.V.C. 112	3 HP	G.E.	Mar. 31, 1921		New	1150				
No. 1								"	"			
No. 2	930060	"	"	"	"							
No. 3												
Sw. hboard No. 1 Panel	285		82" x 20"	Westinghouse.			New					
Storage battery No. 2 "	286		" " 82 x 20"	"	Mar. 31, 1921		"					
Transfermer Dis.			82" x 20"	Walker								
Auxiliaries												
No. 1												
No. 2												
No. 3												

DISTRIBUTION OF KW. Lights 9 K.W.

Power 6 K.W. (Motors-Elev.)

1 Gen.
Panel:
" 1 "
" 1 Dis.
Panel:

REPORT OF COMPLETED WORKS - SEACOAST FORTIFICATIONS


Form 2

Corrected to May 18, 1926.

FORT	Harbor Defenses of Sandy Hook Hancock	STRUCTURE	Provisional (Frame) B.C. Station at Battery Mills	Superseded
------	--	-----------	--	------------

Location	:	:On top of sand fill over magazines, Battery Mills	:Type of data transmission	: Telephones
Date of transfer <i>Cost to date</i>	:	: Feb. 3, 1926.	: Date of transfer	: Feb. 3, 1926.
Type of construction	:	: \$600. (excl. of steel tripod)	: Cost of data transmission equipment	-
(a) Roof	:	: Wood sheathing, waterproofed	: For tide stations give description	:
(b) Remainder of building	:	: frame (steel inst. tripod)	: of tide gage	:
How concealed	:	: No concealment (trees in front) of Battery	: For datum points give Forts from which visible	: All Fort Hancock datum points are visible
How protected	:	: Not protected	: For dormitories give stations served	:
Height above concealment	:	: 32' (above magazine cover)	: For cable hut give S. C. type	-
Height above protection	:	: 32' " "	:	:
Conspicuous at 3000 yards from rear:	:	:	:	:
Not conspicuous " front:	:	:	:	:
Source of electric current	:	: No light or power current	:	:
Kilowatts required	:	: used in station	:	:
Type of lighting fixtures	:	:	:	:
How heated	:	: Not heated	:	:
Connected to water mains	:	: No	:	:
Connected to sewer	:	: No	:	:
Type of latrine	:	:	:	:
Permanent or temporary installation	:	: Semi-temporary	:	:
Present condition	:	: Fair	:	:
Reference of site	:	: (37.0) top of sand cover	:	:
# Reference of instrumental axis	:	: (69.0) top of inst. tripod	:	:
Type of observing instrument	:	:	:	:
Type of plotting board	:	:	:	:
Type and capacity of crane	:	: -	:	:
Max. dimensions of reel handled	:	:	:	:

#Instrument not in place this date.

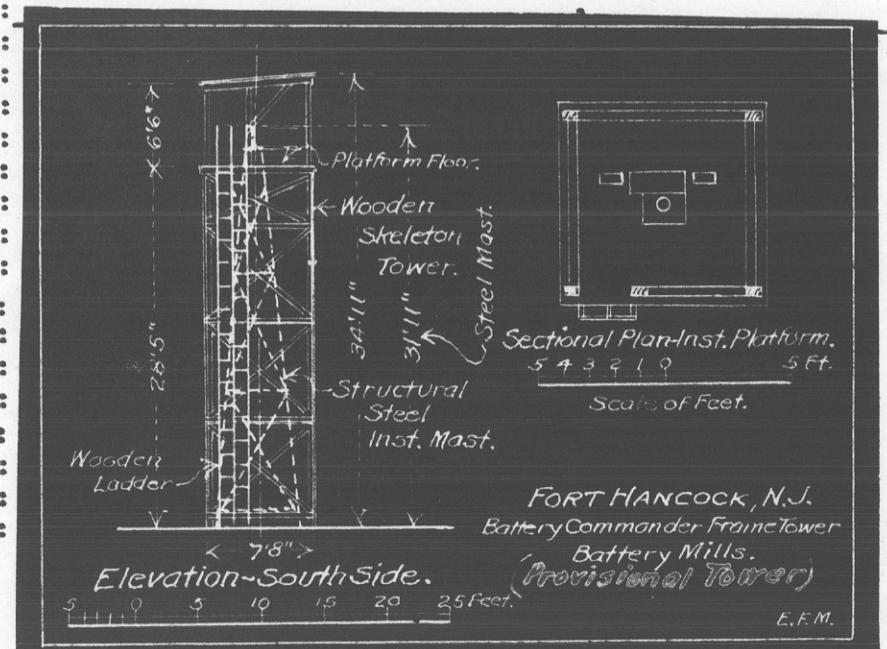

REPORT OF COMPLETED WORKS - SEACOAST FORTIFICATIONS.
(Gun and Mortar Batteries)

Form 1 Corrected to Dec. 10, 1924.

COAST DEFENSES OF Sandy Hook
FORT Hancock, N. J.
BATTERY Mills
No. of guns 2 Caliber 12" Carriage Barbette Model 1917

Battery commenced	:	Mar. 1917.	Sources of electric current	: 2 - 25 K.W. sets
Battery completed	:	Apr. 2, 1921.	:	
Date of transfer	:	Apr. 2, 1921.	Max. kw. required for lights	: 7.850 K.W.
Material of construction	:	Concrete	Max. kw. required for motors	: 15.0 K.W.
Portland or Rosendale cement	Portland	:	:	
Cost to date of transfer	\$297,933.04	:	:	
Connected to water supply	Yes	Present condition battery	:	Excellent
Connected to sewer	Yes (To septic tank)	Rooms wet or dry	:	Dry - some condensation.
Type of latrine	Inside sanitary	:	:	
	flush Syphon	How ventilated	:	
Type of data transmission	Telephones and	:	:	
	Speaking tubes	:	:	
Trunnion elevation in bat-	Empl#1-14.352 ft.	:	:	
tery	:	" #2-14.351 ft.	Remarks:	Steam heat installed in Qtrs, Toilets
Datum plane	M.L.W.	:		& Plotting Rooms, Sept. 1919.
	:	:		

ARMAMENT

Emplacement:	Guns or Mortars						Carriages					
No.	Mortaxx Noxx	Cal.	Length	Model	Serial No.	Manufacturer	Mounted	Type	Model	Ser. No.	Manufacturer	Motor
1		12"	35 cal.	1895 MI	69	Ordnance Dept.	Nov. 1919	Barbette	1917	9	Ordnance Dept.	None
2		12"	do.	do.	46	do.	Oct. 1919	do	1917	8	do.	none
3		:	:	:	:	:	:	:	:	:	:	
4		:	:	:	:	:	:	:	:	:	:	
5		:	:	:	:	:	:	:	:	:	:	
6		:	:	:	:	:	:	:	:	:	:	
7		:	:	:	:	:	:	:	:	:	:	
8		:	:	:	:	:	:	:	:	:	:	

HOISTS

Emplacement:	Motor	Date of control	Remodeled for long points.
Number	Type: Delivery: Ser. No.: Maker: H.P.: Volts: RPM: Type of transfer:		

Trolley hoists (hand chain hoists) operating on I beam track are installed in powder and shell rooms.

2. Electric sump pumps installed in M.H. Gun #1 & #2
See Report of Operations December, 1936. 2nd C.A.

Superseded:
See Form 1,
June 3, 1937

Over

Major Repair work since July 1, 1923.

F.Y. 1927 - Conc. platforms and retaining walls \$ 4200 - This incl. similar
work at Batty. Kingman.

1928 - Service Ry. for Mills & Kingman \$ 6210

REPORT OF COMPLETED WORKS - SEACOAST FORTIFICATIONS

Corrected to

Dec. 10, 1924.

COAST DEFENSES OF SANDY HOOK.
FORT HANCOCK.

BATTERY MILLS

No. of Guns - 2.

Scale: 1" = 60'


Caliber - 12"

Carriage - Barbette.

True north

EMP. NO. 2.


BATTERY MILLS.

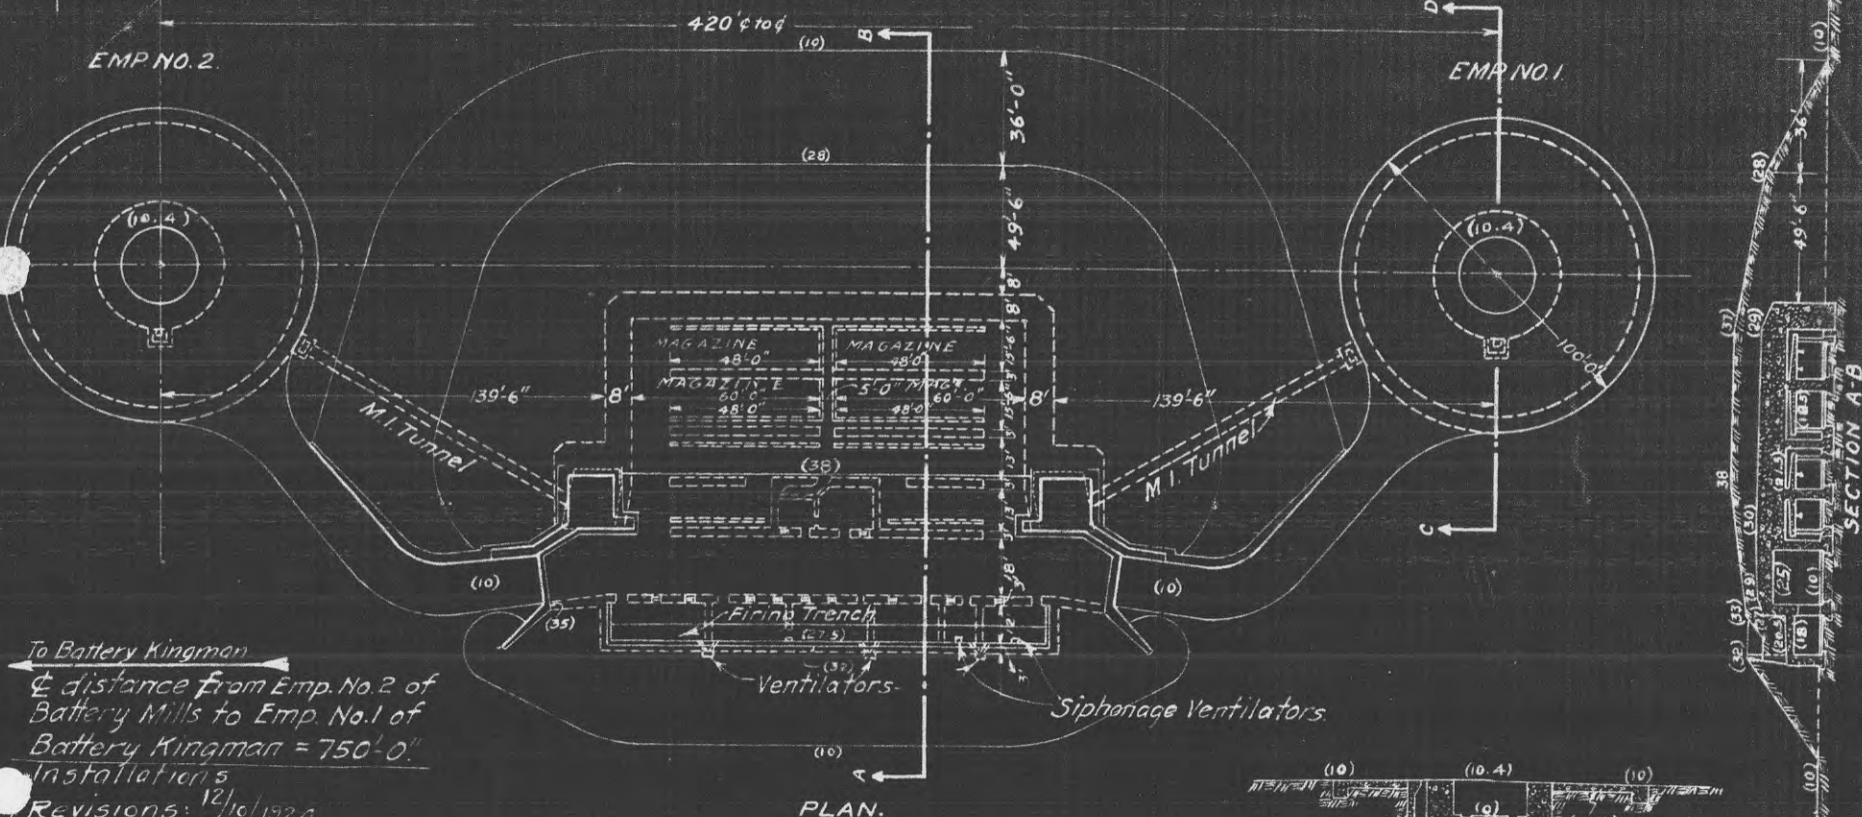

Installations
Revisions: 12/10/1924

Steam heat installed in Qrs. Tickets, Plotting
Rooms, Sept. 1919.

SECTION C-D

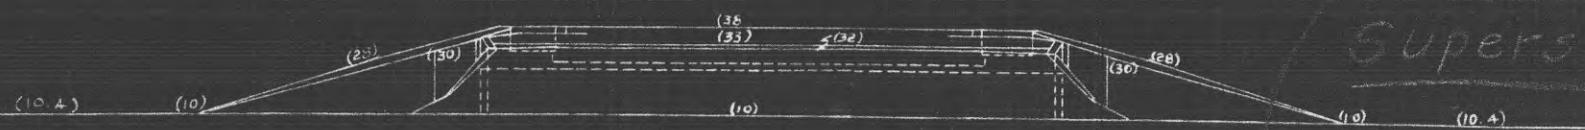

REAR ELEVATION.

(Superseded)

See Blueprint
June 3, 1937

REPORT OF COMPLETED WORKS - SEACOAST FORTIFICATIONS.
 (Gun and Mortar Batteries)
 With 600 B (Sandy Hook) 18
 Form 1 Corrected to June 3, 1937.

HARBOR DEFENSES OF Sandy Hook
 FORT Hancock, N. J.
 BATTERY Mills
 No. of guns 2 Caliber 12" Carriage-Barbette Model 1917

Battery commenced	March 1917.	Sources of electric current	2 - 25 K.W. sets, and 3 phase AC (connected to Jersey Central Power & 7.850 k.w. Light Co. line supplying current to QM)
Battery completed	Apr. 2, 1921.	Max.kw. required for lights:	
Date of transfer	Apr. 2, 1921.	Max.k.w. required for gun motors. (Note: One 10 h.p. and one 3 h.p. motor for air conditioning equipment on 3 phase AC line not included in above.)	
Material of construction	Concrete		15.0 k.w.
Portland or Rosendale cement	Portland	Present condition battery	Excellent
Cost to date of transfer	\$297,933.04	Rooms wet or dry	Dry - (condensation would exist without air conditioning.)
Connected to water supply	Yes	How ventilated (See also des- cription on reverse side of air conditioning equipment installed.)	Through grating doorways and windows, & motor driven blower connecting to air ducts to magazines. All magazines are separate rooms with air passages between.
Connected to sewer - Yes	(To septic tank)	Remarks:	Steam heat installed in quarters, toi- lets & Plotting Rooms, Sept. 1919.
Type of latrine	Inside sanitary flush Syphon jet (tank)		
Type of data transmission	Telephones and speaking tubes		
Trunnion elevation in battery	Empl #1-14.352 ft. " #2-14.351 ft.		
Datum plane	M.L.W.		

ARMAMENT

Emplacement					Guns or Mortars				Carriages				
No.	Cal.	Length	Model	Serial #	Manufacturer	Mounted	Type	Model	Serial #	Manufacturer	Motor		
1	12"	35 cal.	1895 MI	69	Ordnance Dept.	Nov. 1919	Barbette	1917	9	Ordnance Dept.	None		
2	12"	do.	do.	46	do.	Oct. 1919	do	1917	8	do.	None		
3													
4													
5													
6													
7													
8													

HOISTS

Emplacement	Type	Delivery	Serial #	Maker	H.P.	Volts	RPM	Type of control	Date of transfer	Remodeled for long points.
No.										

Trolley hoists (hand chain hoists) operating on I beam track are installed in powder and shell rooms.

(over)

Plan of Air Conditioning Equipt,
 see O.C.E. 46-100 A-6

Modifications

In January 1937, the installation of dehumidifying and air circulating equipment to eliminate condensation was installed as shown on separate blueprint plan (2) attached, as follows:

Material - Freon gas compressor, cooling coil, heating coil, fan, humidistat, control switches, ducts and grilles -

Labor -

Material	\$2,113.00
Labor	1,080.00
Total	\$3,193.00

(The cost of installing a three-phase AC line to Battery Mills was \$1362, which was not included in above).

The cost of the water supply equipment is as follows:

1 - Pumping unit,
(Deming Company's unit #83400, 930 gallons per hour capacity, $1\frac{1}{2}$ " discharge, with $1\frac{1}{2}$ h.p. motor) -

Material	\$ 121.00
Labor	9.75

Check and relief valves and gauge -

Material	\$ 44.25
----------	----------

Electric panel board with pressure switch and gauge and magnetic starting switch -

Total	\$ 175.00
-------	-----------

(Tanks were from surplus stock.)

REPORT OF COMPLETED WORKS - BEACOAST FORTIFICATIONS HARBOR DEFENSES OF SANDY HOOK

FORT HANCOCK.


BATTERY MILLS

No. of Guns - 2.


Scale: 1" = 60' 10' 10' 10' 30' 40' 50' 60'

Carriage-Barbette.

Corrected to JUNE 3, 1937.

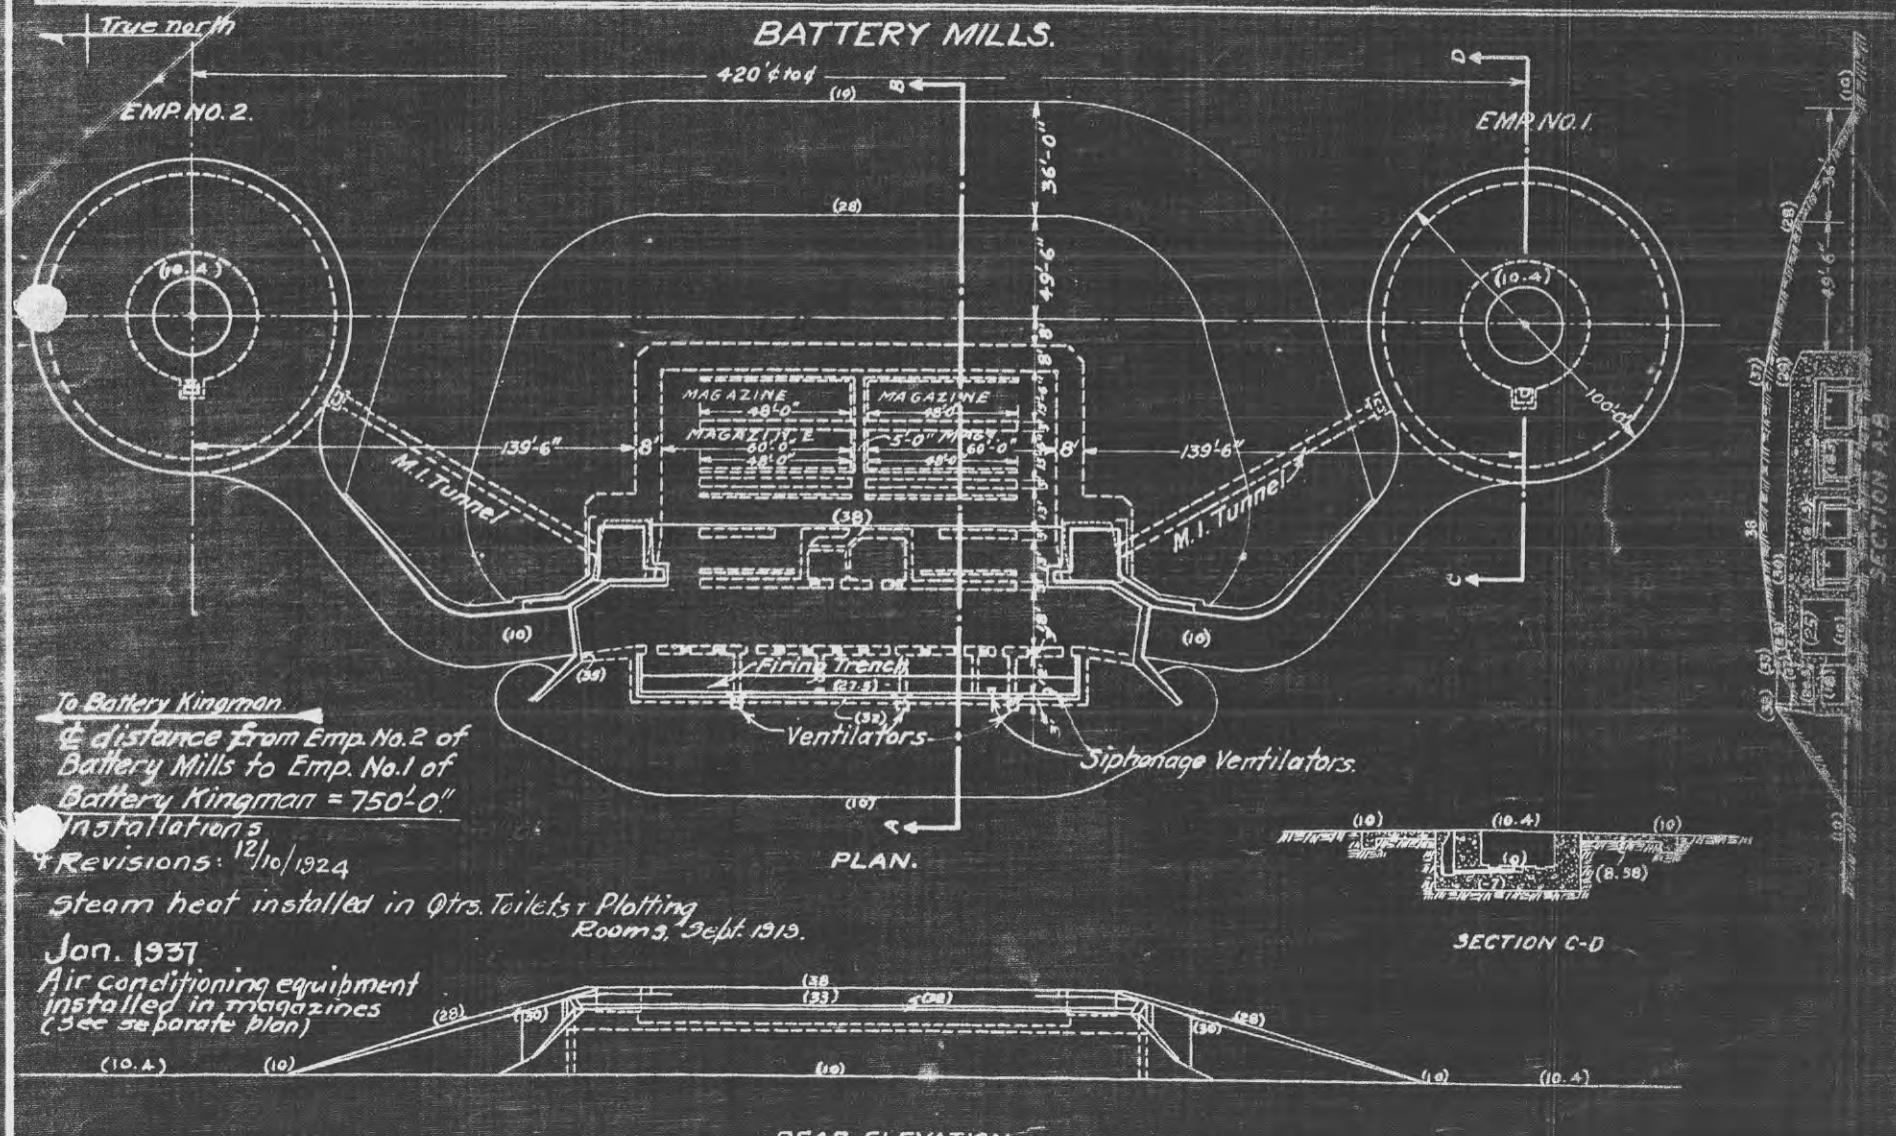

REAR ELEVATION.

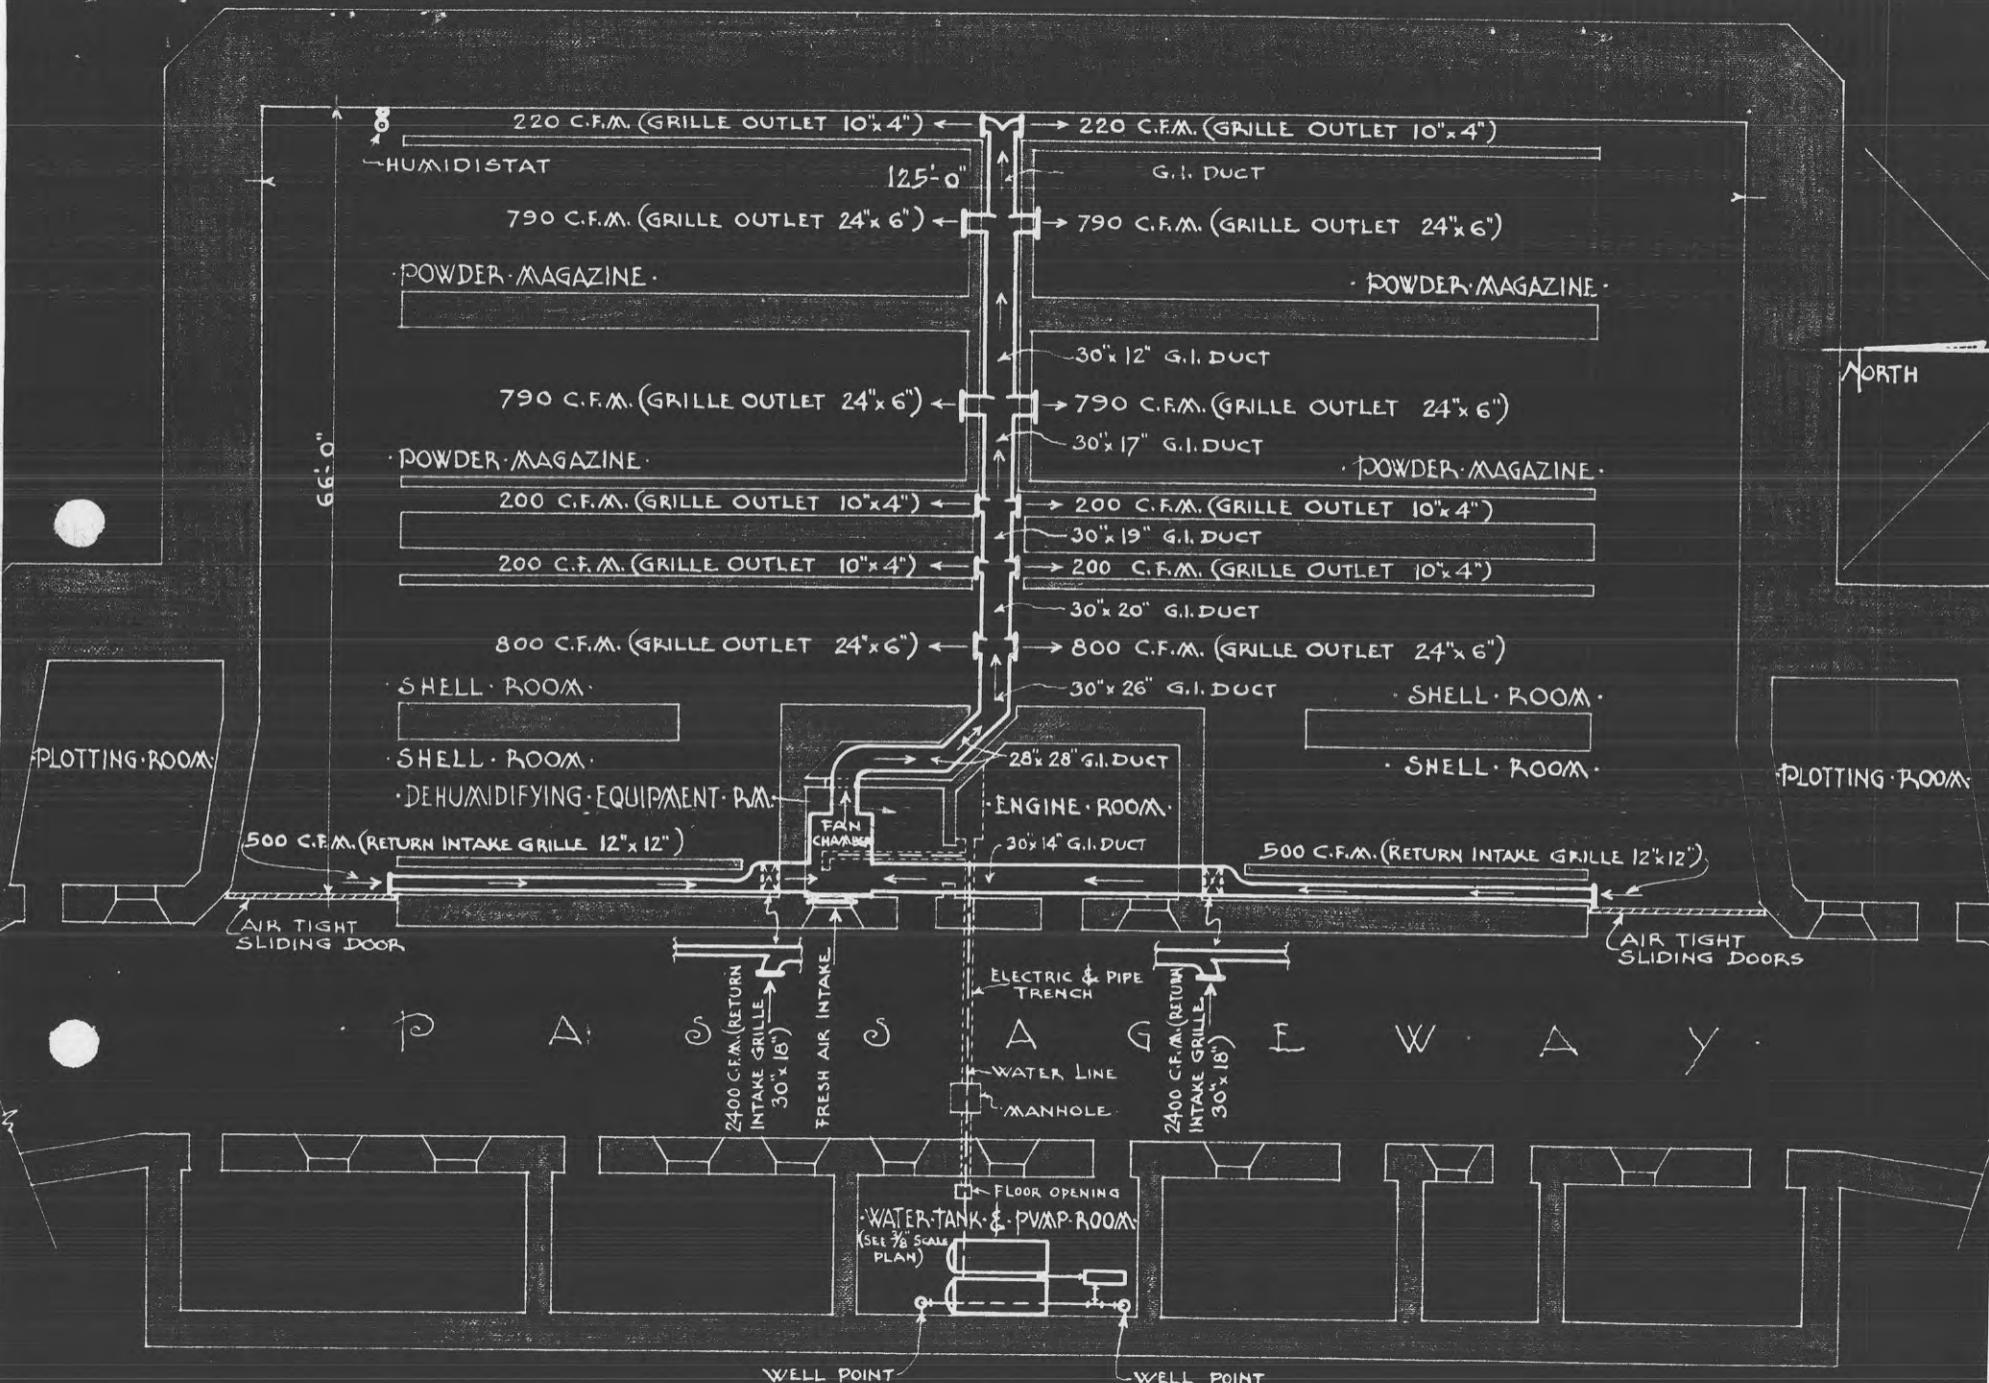

600 (78) 10220
 REPORT OF COMPLETED WORK - SLACOAST FORTIFICATIONS
 (Batteries)

Part I 114-20 Corrected to 28 NOV. 1944

HARBOR DEFENSES OF NEW YORK
 FORT HANCOCK, NEW JERSEY
 BATTERY MILLS * No. of Guns 2
 Caliber 12" Carriage BARBETTE

SPEAKMAN

GENERAL:

Battery commenced March 1917
 Battery completed 2 April 1921
 Date of transfer 2 April 1921
 Cost to date of transfer \$297,953.04 Project 270 funds
 Materials of construction Concrete
 Battery new or modernized Modernized
 (If modernized give detailed statement
 on reverse side) No. 1 - El. 14.352
 Trunnion elevation in ft. - El. 14.351
 Datum plane Mean Low Water

UTILITIES:

WATER SUPPLY

Source of Reservation System
 Alternate source --
 Size of Main 6" of Transite
SEWER
 Connected to sewer Yes
 Type of Disposal Septic Tank
 Type of Latrine Sanitary Flush Syphon Jet (Tank)

UTILITIES (Cont'd.)

ELECTRIC POWER

Sources of Engine Generators & Commercial
 Procured & installed by (OCE or ORD) Commercial by O.C.E.
 Characteristics: Voltage 450/120/208 Engine Generators by
 AC ex-DC Phase 3 Ord.
 No. of units and capacity 3
 Max. K.W. required for utilities 25 KVA
 Max. K.W. required for non-battle conditions 25 KVA
 Commercial power provided (yes or no) Yes Capacity 50 KVA
 Auxiliary power unit provided (yes or no) No Capacity
 Type of lighting fixtures Std. U.S.B.D. & Comm. Std. C.R.F
 Dehumidifying Unit.. Make and capacity Westinghouse
 Rooms Wet or Dry DRY 10 H.P. *
 How ventilated Vent shafts (Plott. Rms.) Exhaust fans (Rm.)
 How heated Steam heat installed in quarters, latrines
DATA TRANSMISSION & plotting rooms - Sept. 1919.
 Type Telephones

REMARKS

See attached sheet for additional construction
 *3 H P Dehumidifying units in main corridors

ARMAMENT

Emplacement No.	Cal.	Length	Model	Guns	Serial No.	Manufacturer	Mounted	Type	Carriages			
									Model	Serial No.	Manufacturer	Motor
1	12"	35 Cal.	1895 M-1	69	Ordnance Dept.	Nov. 1919	Bar-bette	1917		9	Ordnance Dept.	None
2												
3	12"	35 Cal.	1895 M-1	46	Ordnance Dept.	Oct. 1919	Bar-bette	1917		8	Ordnance Dept.	None

* Declared Excess to the Army by AGF
 in accordance with instructions in
 the contract

2nd 2

Nature & Cost of Additional Repairs & Modifications (Battery Mills)

1923

Sump pump installation.....\$ 200.00

1925

Modifications to Plotting Room..... 1,500.00

January 1937

Installation of dehumidifying and air circulating equipment to eliminate condensation.

Material:	Freon gas compressor, cooling coil, heating coil, fan, humidistat, control switches, ducts.....	2,113.00
Labor.....		1,080.00
		\$ 3,193.00

1937

Electric power installation - 3 phase AC line to Batt. Mills....\$ 681.00

1937

Water supply system-

Equipment:	Pumping unit Deming Co. unit #83400, 930 gallons per hr. capacity, 1½" discharge with 1½ H.P. motor.....	121.00
Check & relief valves and gage.....		9.75
Electric panel board with pressure switch & gauge and magnetic starting switch.....		44.25
(Tanks were from surplus stock)		
		\$ 175.00

1942-1943

(a) Casemate & corridors added to original magazine.....	475,097.27
(b) Power Room added to C.T. Magazine.....	131,745.63
(c) Electrical Power Extension.....	1,760.77
(d) Gasproofing system installed.....	6,582.54
(e) Alterations to original septic tanks.....	1,510.84
(f) Additions to original ventilating system.....	2,463.22
(g) New wood doors (Power Magazine Rooms).....	590.35
(h) Blastproofing - Modifications resulting from gunfire tests.	4,068.18
Total.....	\$623,818.80

1944

Power Room Heating System

FS-294 2270.97
626.059.77

This project consists of the installation of oil fired hot water boiler, induced draft fan.

4 unit heaters and necessary piping.

2 new closures to isolate heated areas as follows: Power Room, Water Cooler Room, Muffler Gallery and Corridor.....\$2,240.97

1944 - Additional Dehumidification System.

FS-996

This project consists of installation of 3 self-contained dehumidifying units with 3 H.P. compressor. Necessary wiring, ductwork, condensate dry wells and closures for corridors.....\$10,033.72

FS-143441423

Mills

Nature & Cost of Additional Repairs & Modifications (Cont'd.)

1944 - This project consists of the removal of existing direct current, gasoline engine driven generators, switchboard, jacket water cooling radiators and related equipment. Restoration of floors and miscellaneous repairs.....\$ 1,380.00

637,473.49

Statement of nature and cost of all major repairs or modifications on
the structure since 1925 -

July 1943 -

Spotting, boiler, generator, C.W.S., and latrine rooms added.
Gasproofing and dehumidifying systems installed..... \$41,552.12

SECRET

REPORT OF COMPLETED WORKS - SEACOAST FORTIFICATIONS

Corrected to Dec. 10, 1924.

COAST DEFENSES OF SANDY HOOK.

FORT HANCOCK.

BATTERY MILLS


No. of Guns - 2.

Caliber - 12"


Scale: 1" = 60' ~~1' = 60'~~

Carriage-Barbette.

True north

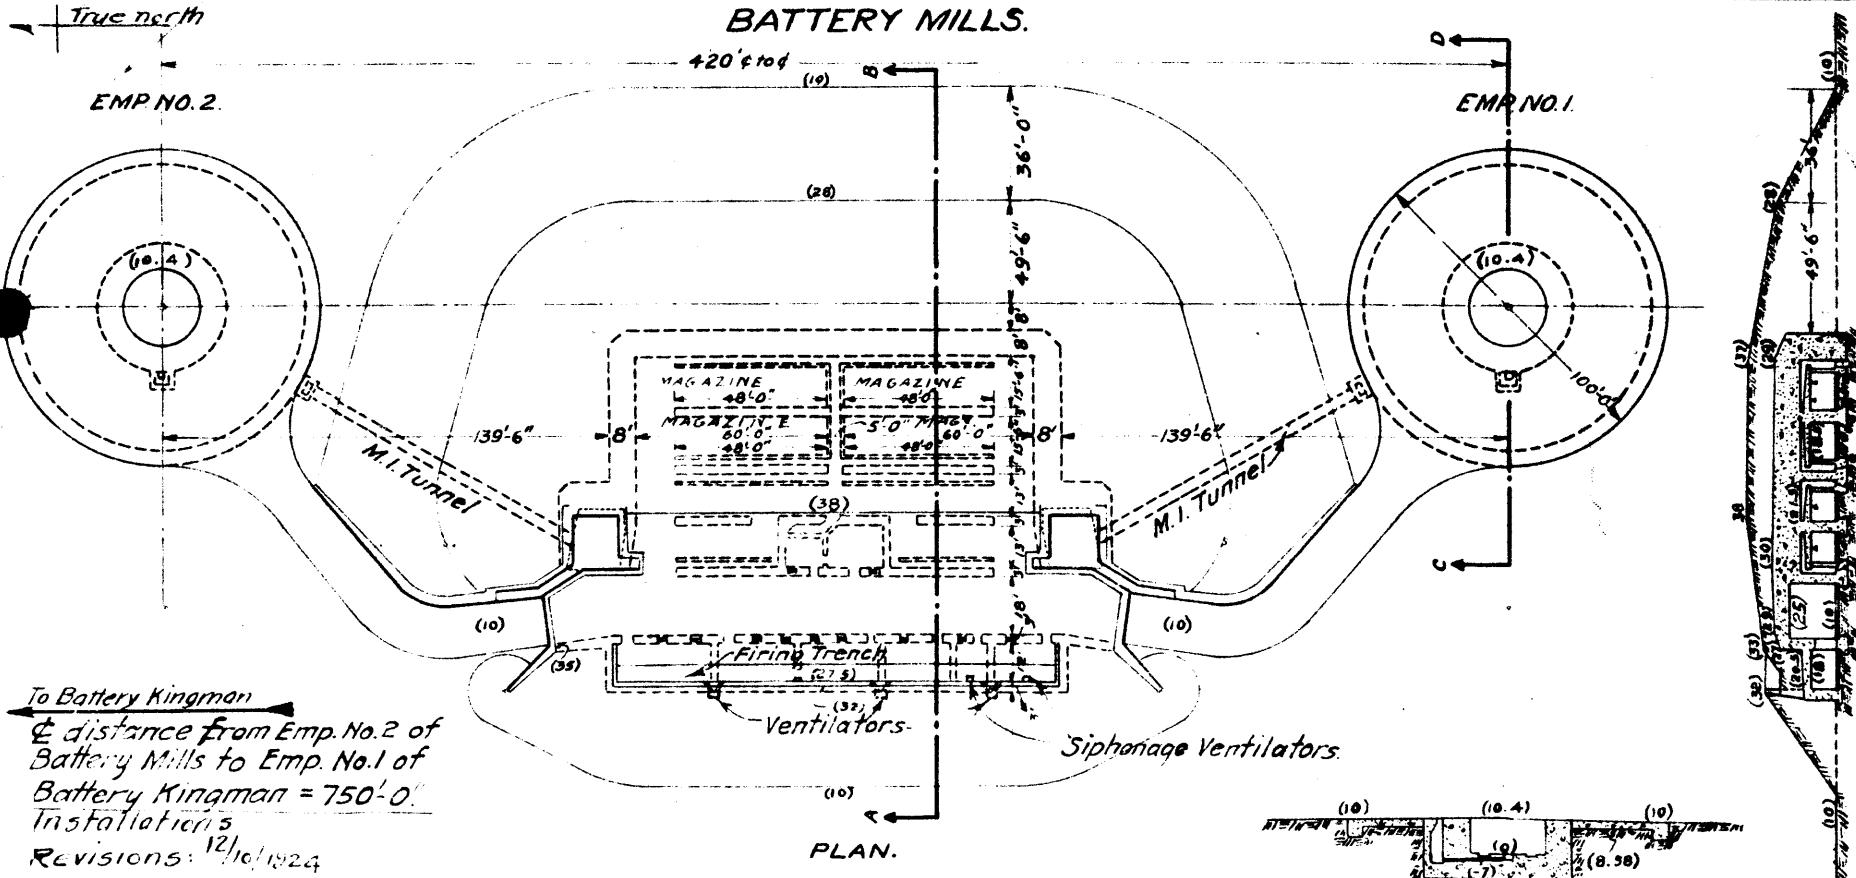

SECTION C-D

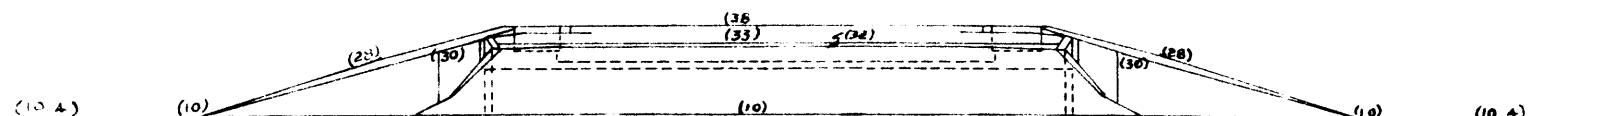

REAR ELEVATION.

REPORT OF COMPLETED WORKS - SEACOAST PORTIFICATIONS

HARBOR DEFENSES OF SANDY HOOK.

FORT HANCOCK.

BATTERY MILLS

No. of Guns - 2.

Caliber - 12"


Corrected to JUNE 3, 1937.

Scale: 1" = 60'

Carriage - Barbettie.

True North

EMP. NO. 2.

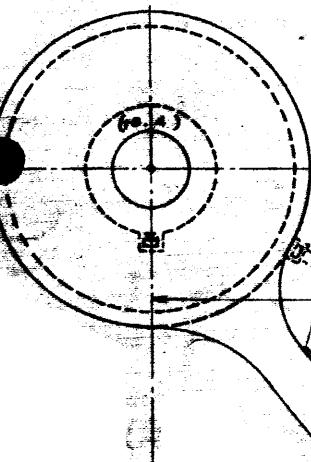

BATTERY MILLS.

420' to S.

(10)

(20)

36'

36'


36'

36'

36'

36'

EMP. NO. 1.

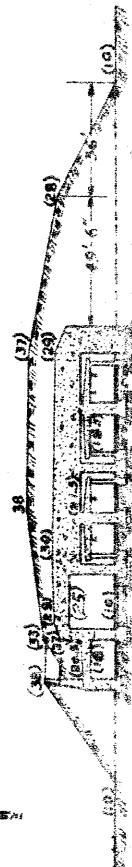

PLAN.

To Battery Kingman.

Distance from Emp. No. 2 of
Battery Mills to Emp. No. 1 of
Battery Kingman = 750'-0"

Installations

Revisions: 12/10/1924

Steam heat installed in Qtrs. Toilets, Plotting
Rooms, Sept. 1919.


Jan. 1937

Air conditioning equipment
installed in magazines
(see separate plan)

(10.4) (10) (10) (20) (20) (20) (20) (20) (20) (10) (10.4)


SECTION C-D


REAR ELEVATION.

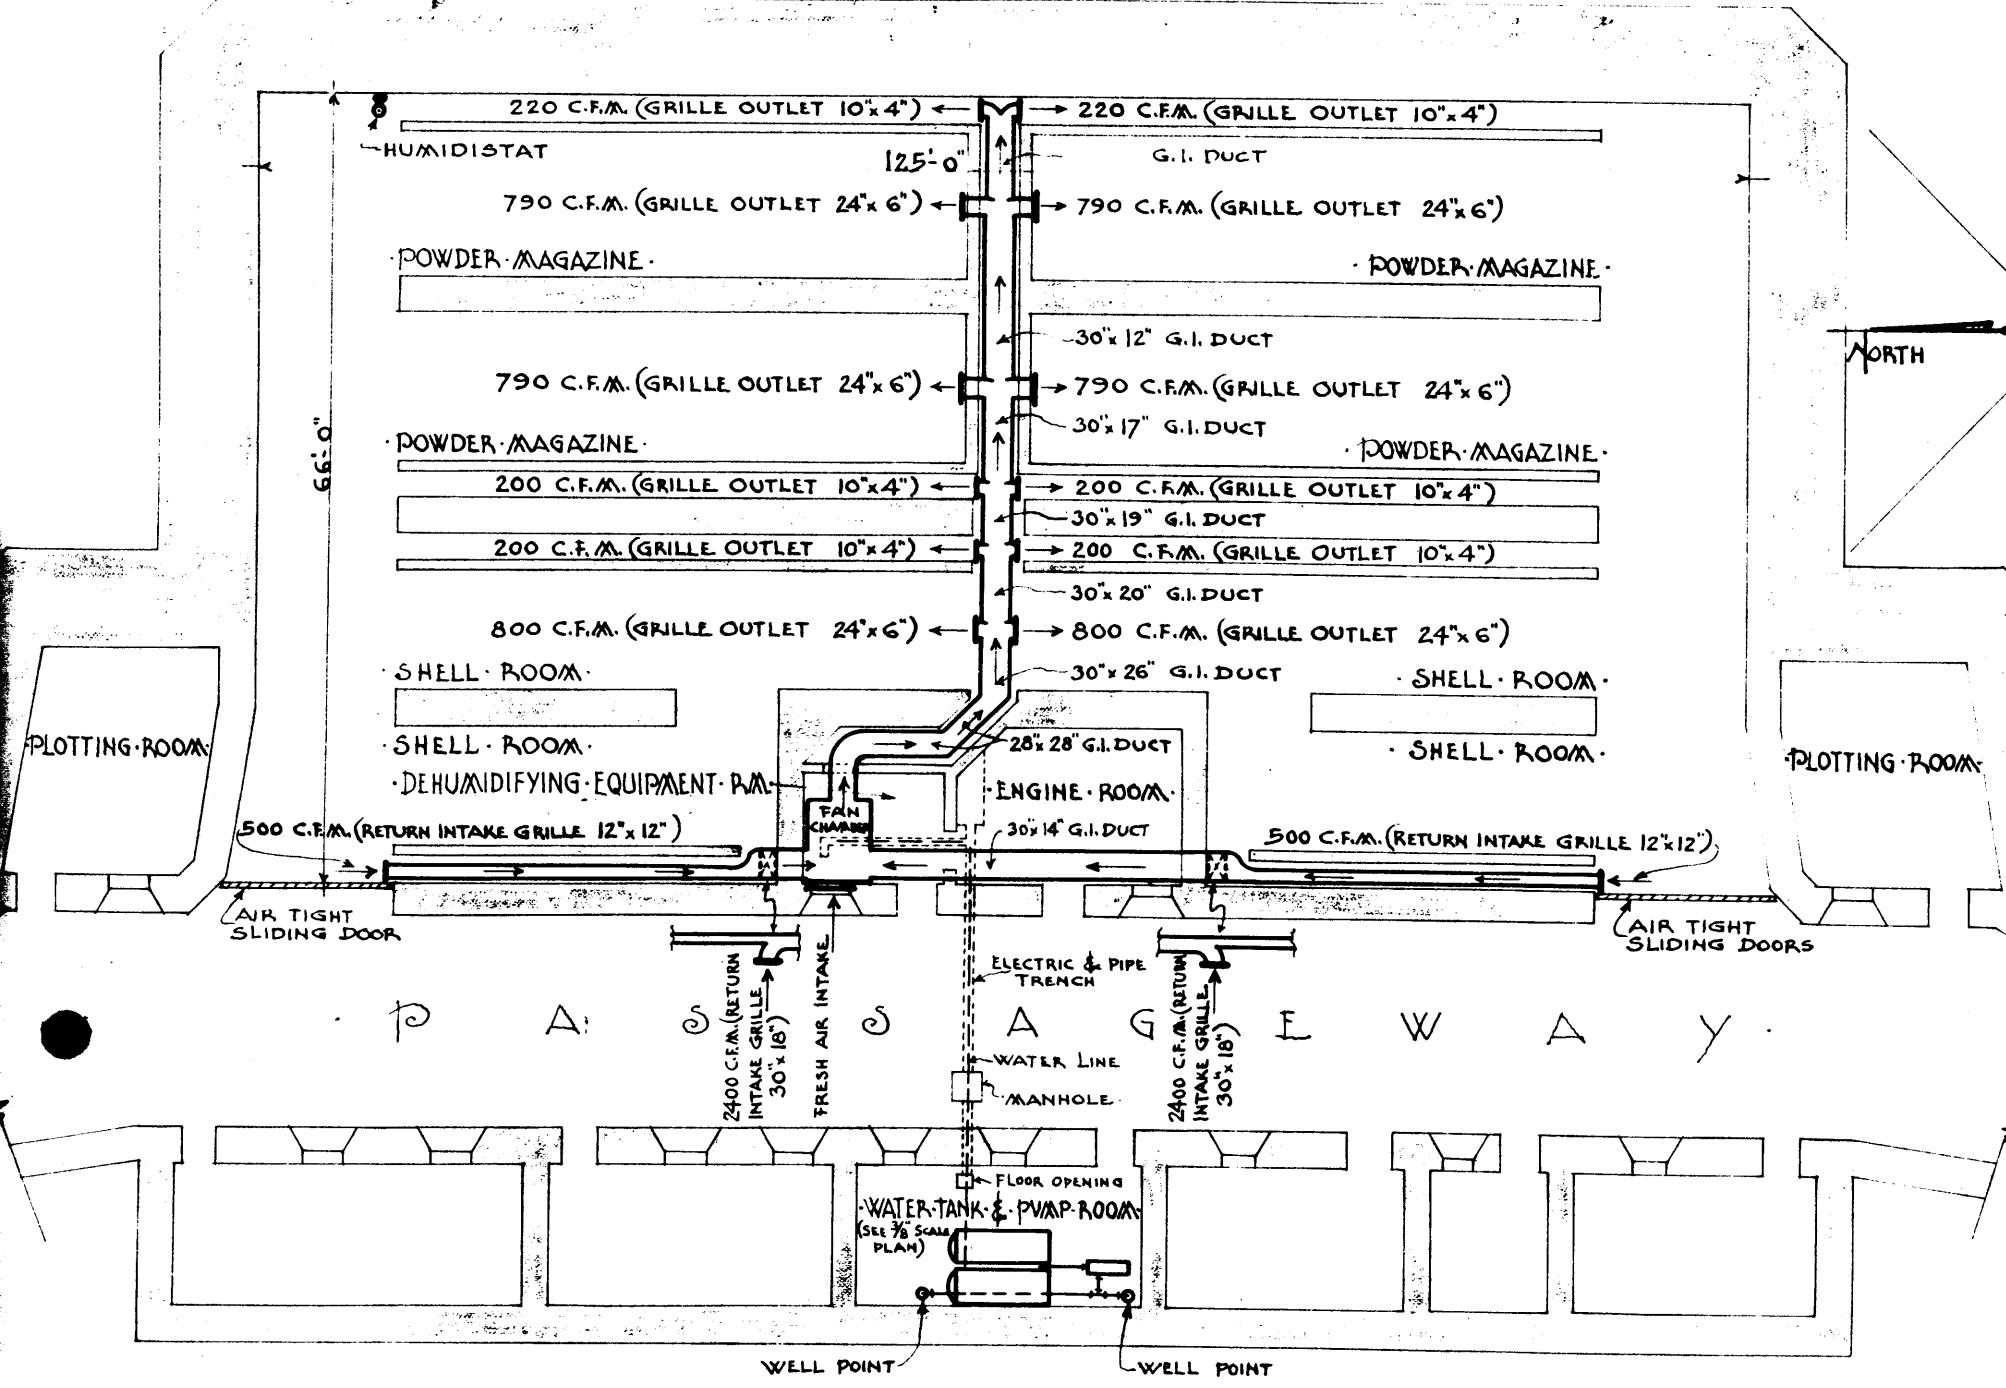

WAR DEPARTMENT


CORPS OF ENGINEERS, U.S. ARMY

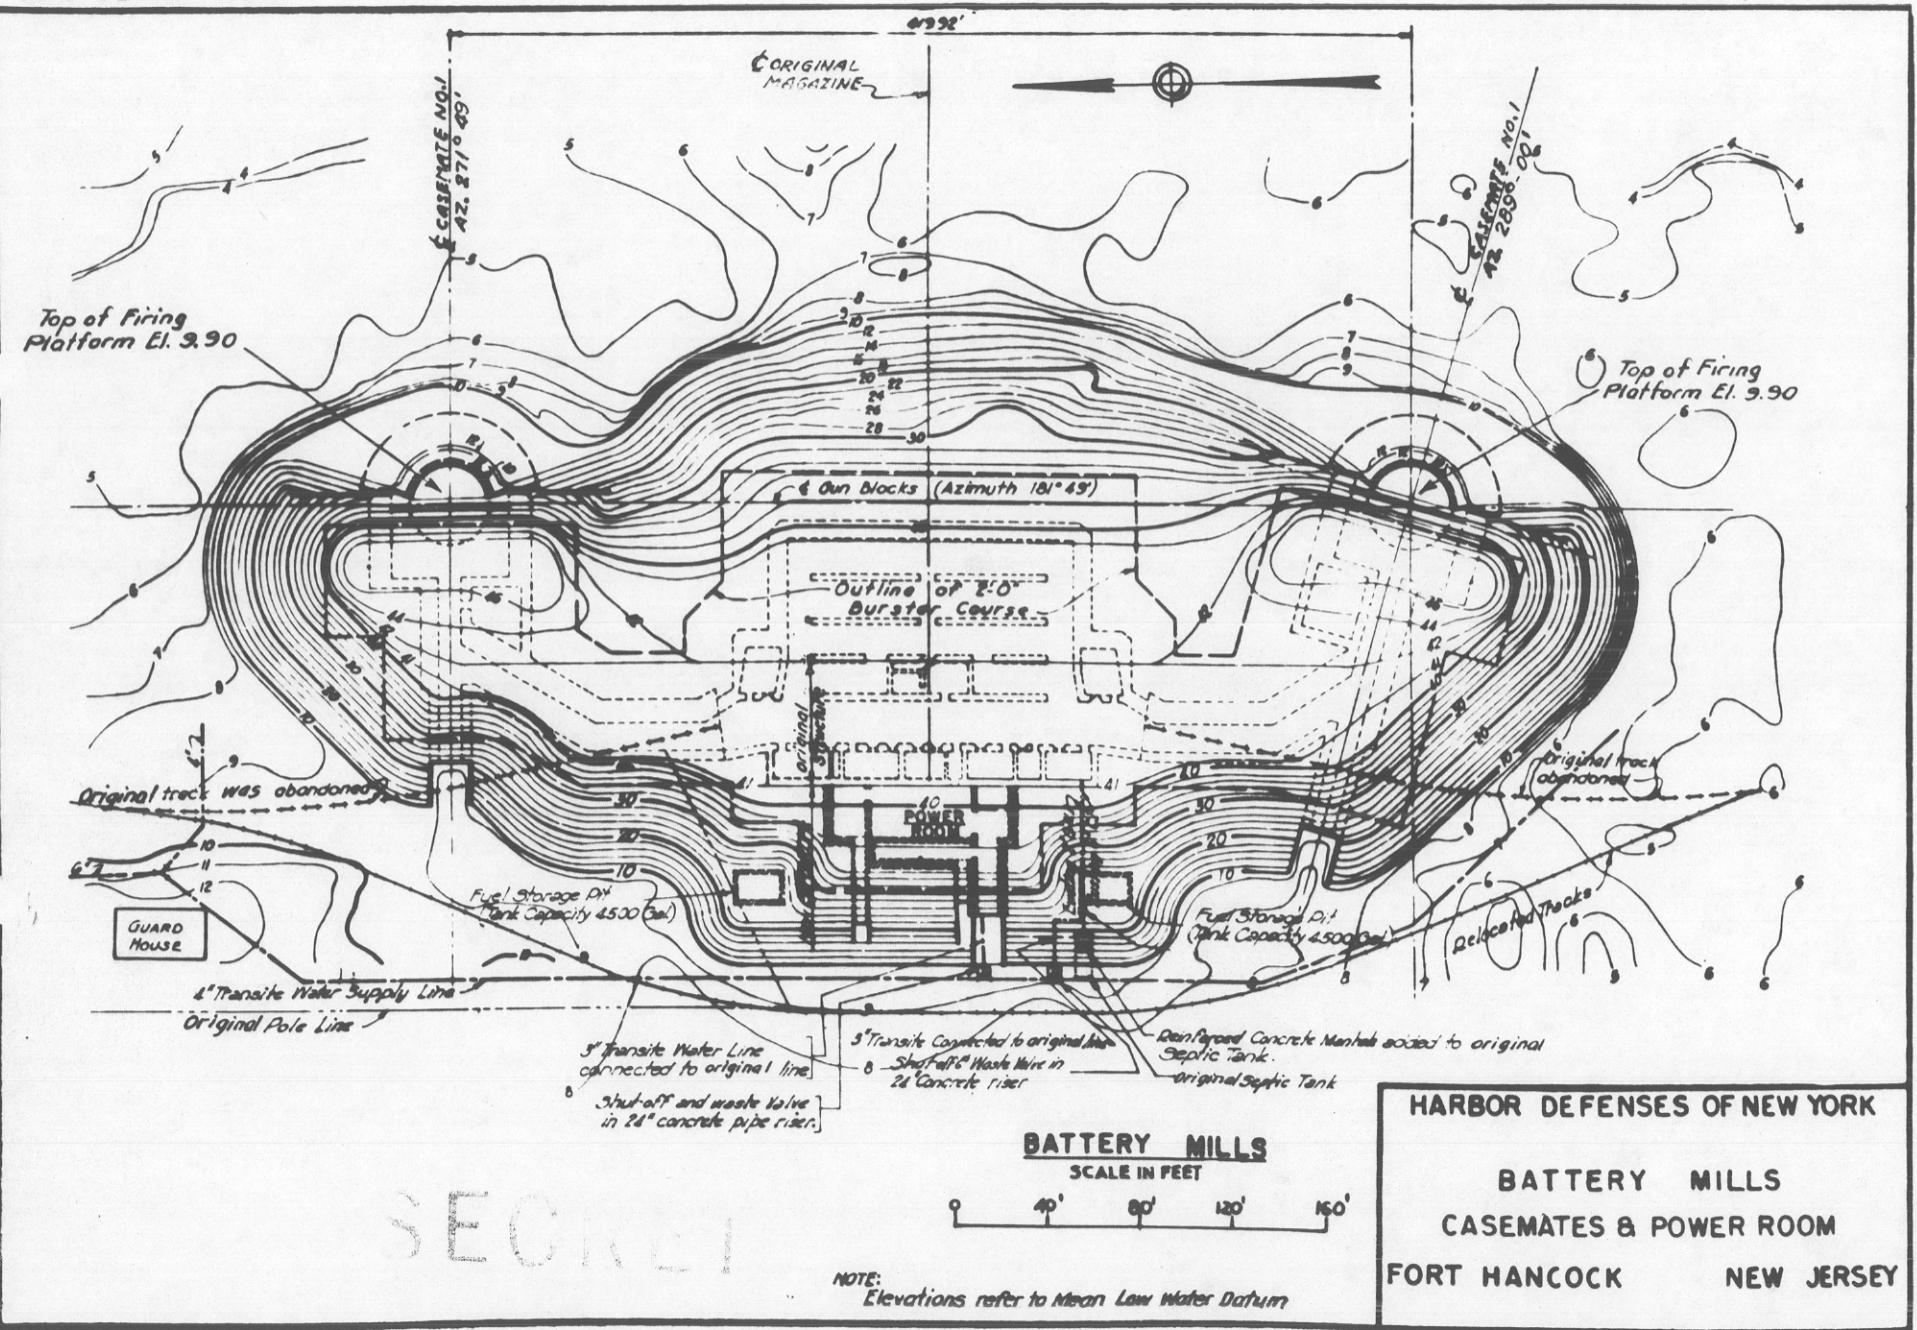


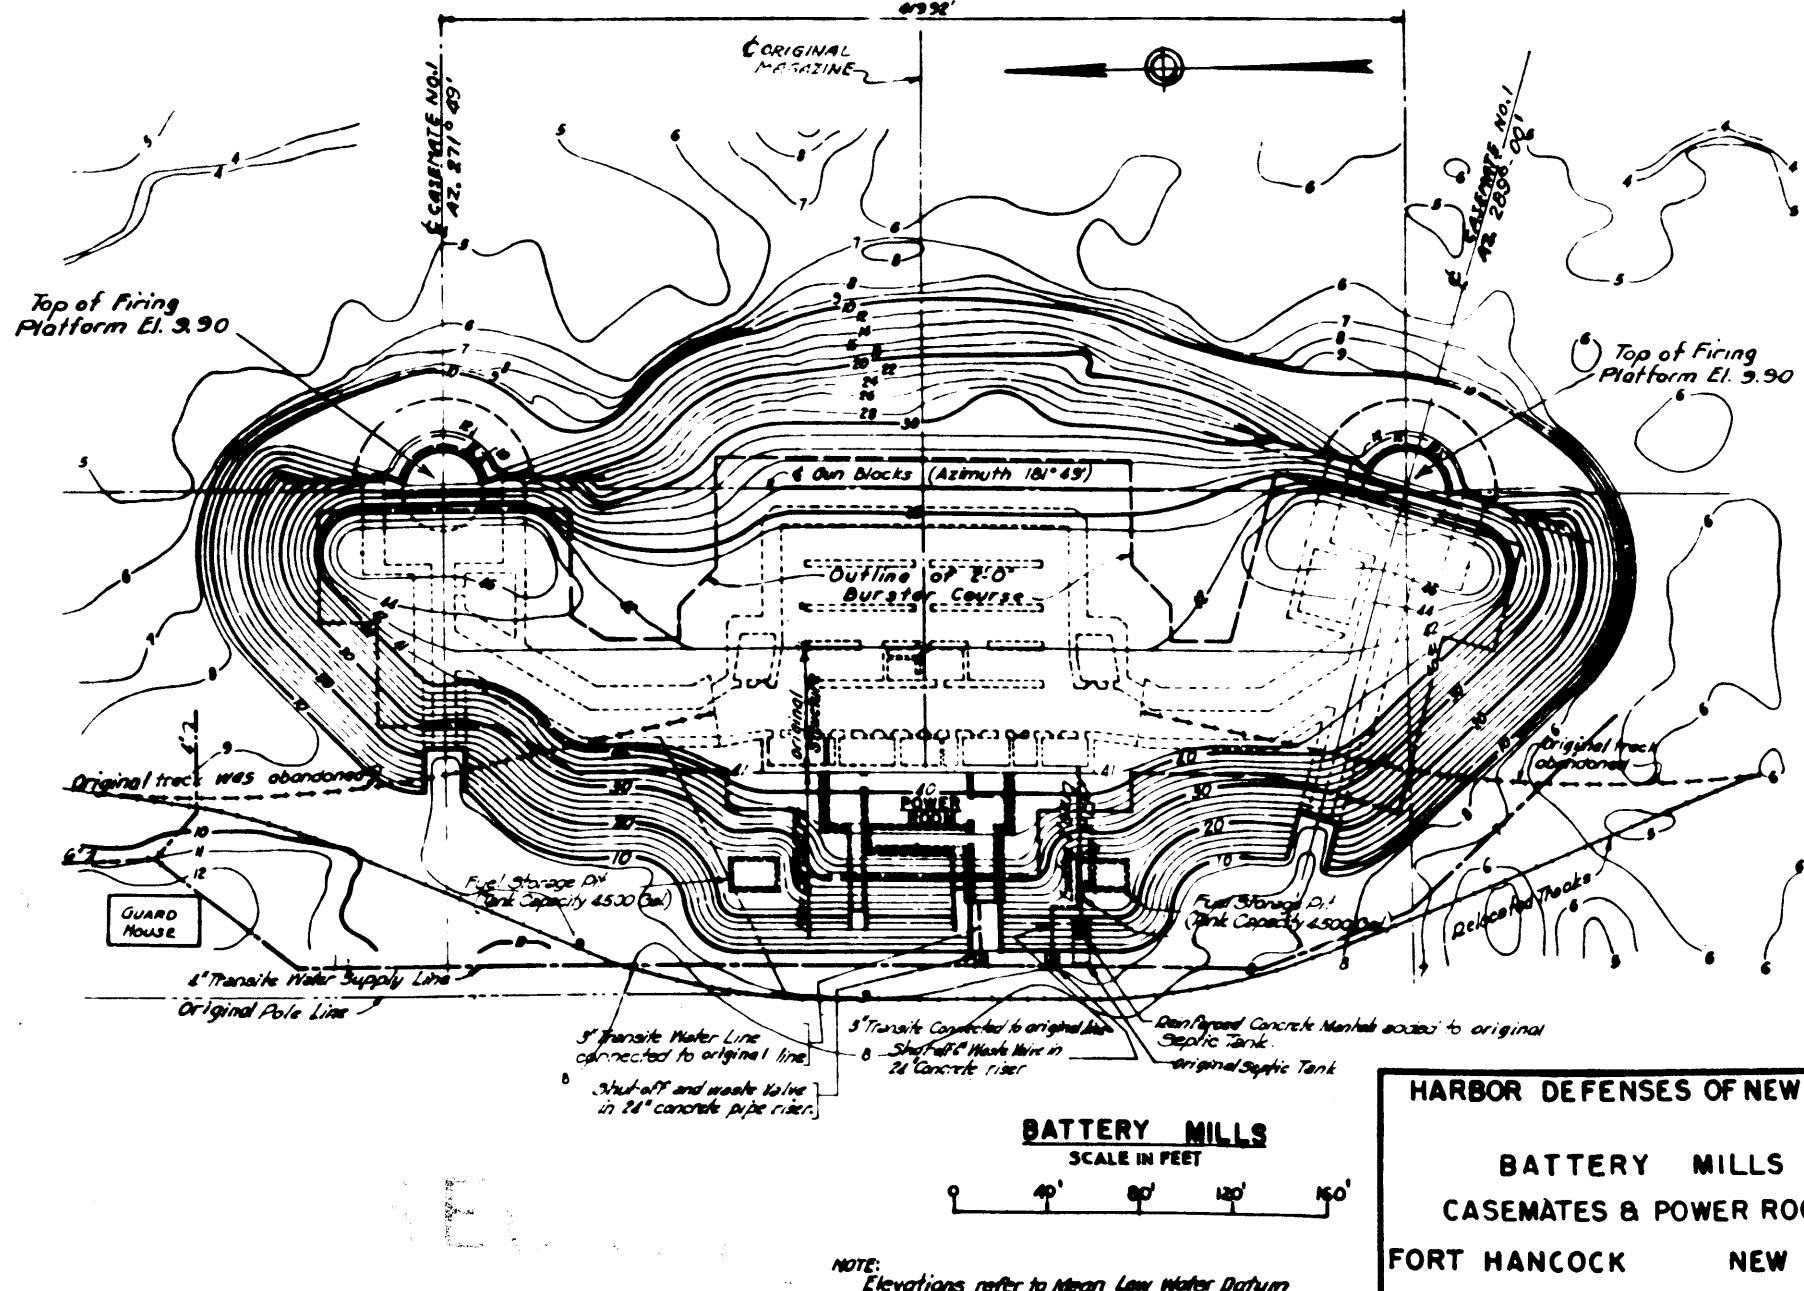

WAR DEPARTMENT


CORPS OF ENGINEERS, U.S. ARMY

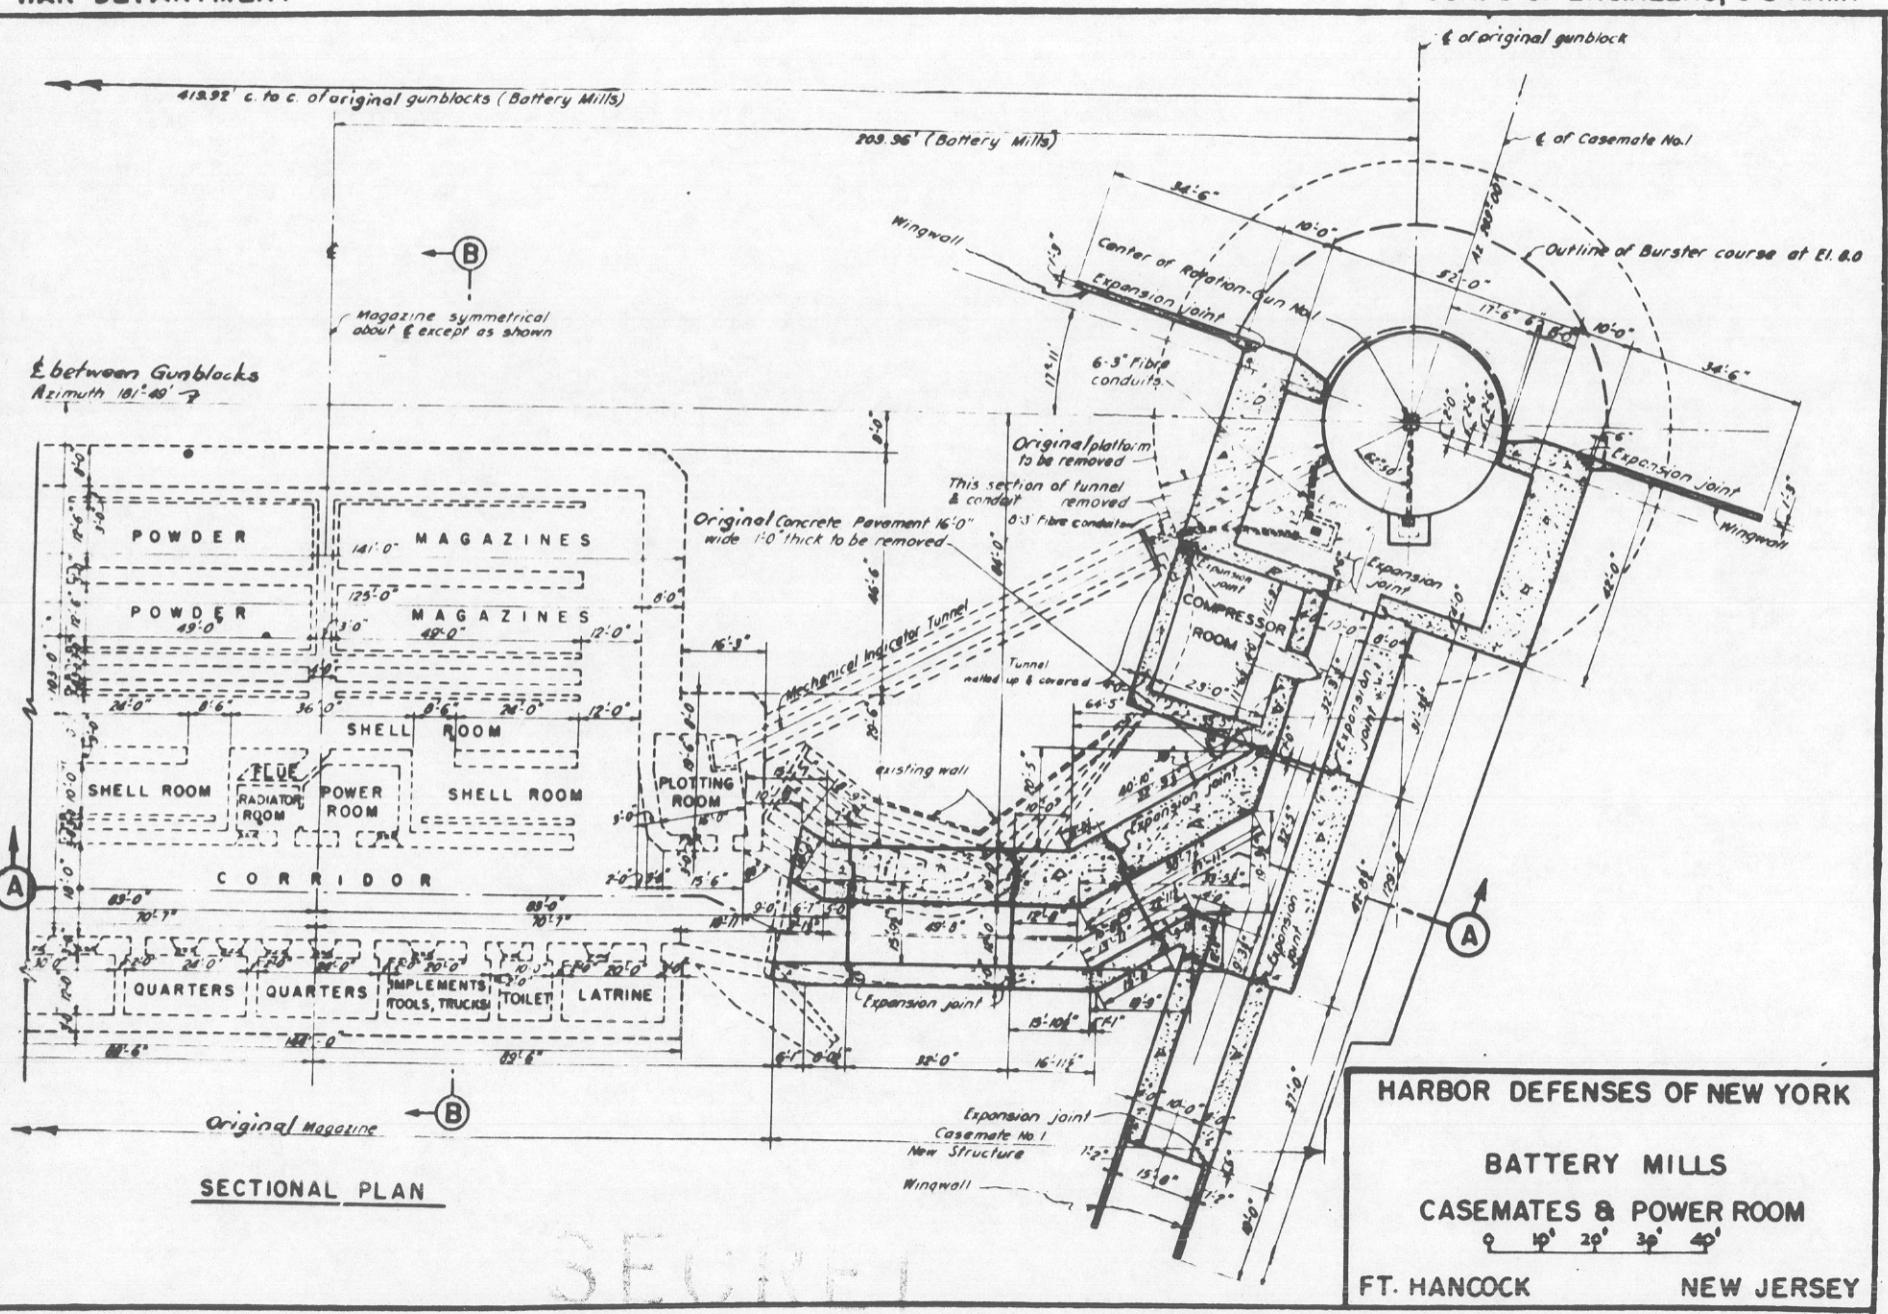


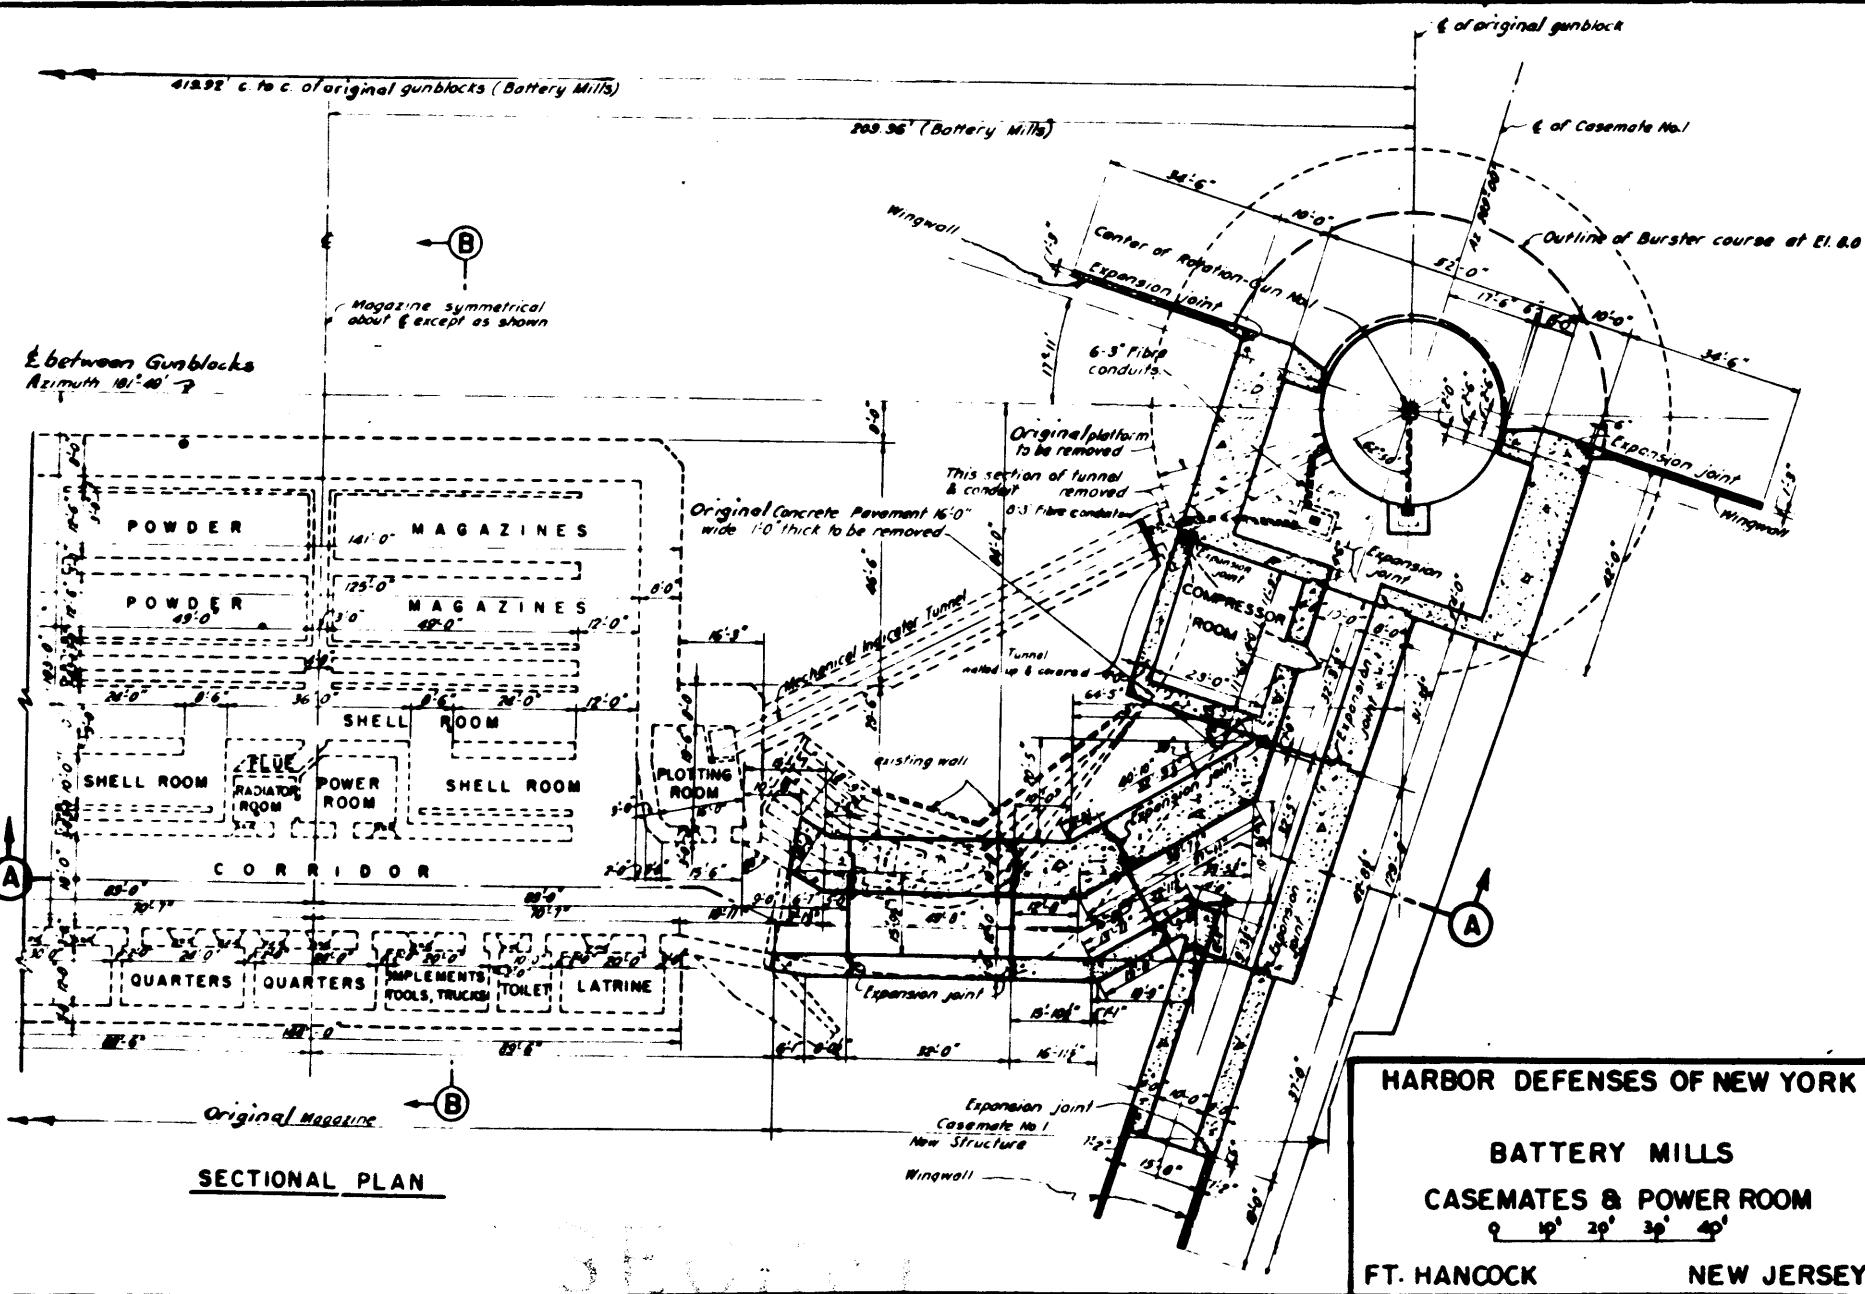

WAR DEPARTMENT

CORPS OF ENGINEERS, U.S. ARMY

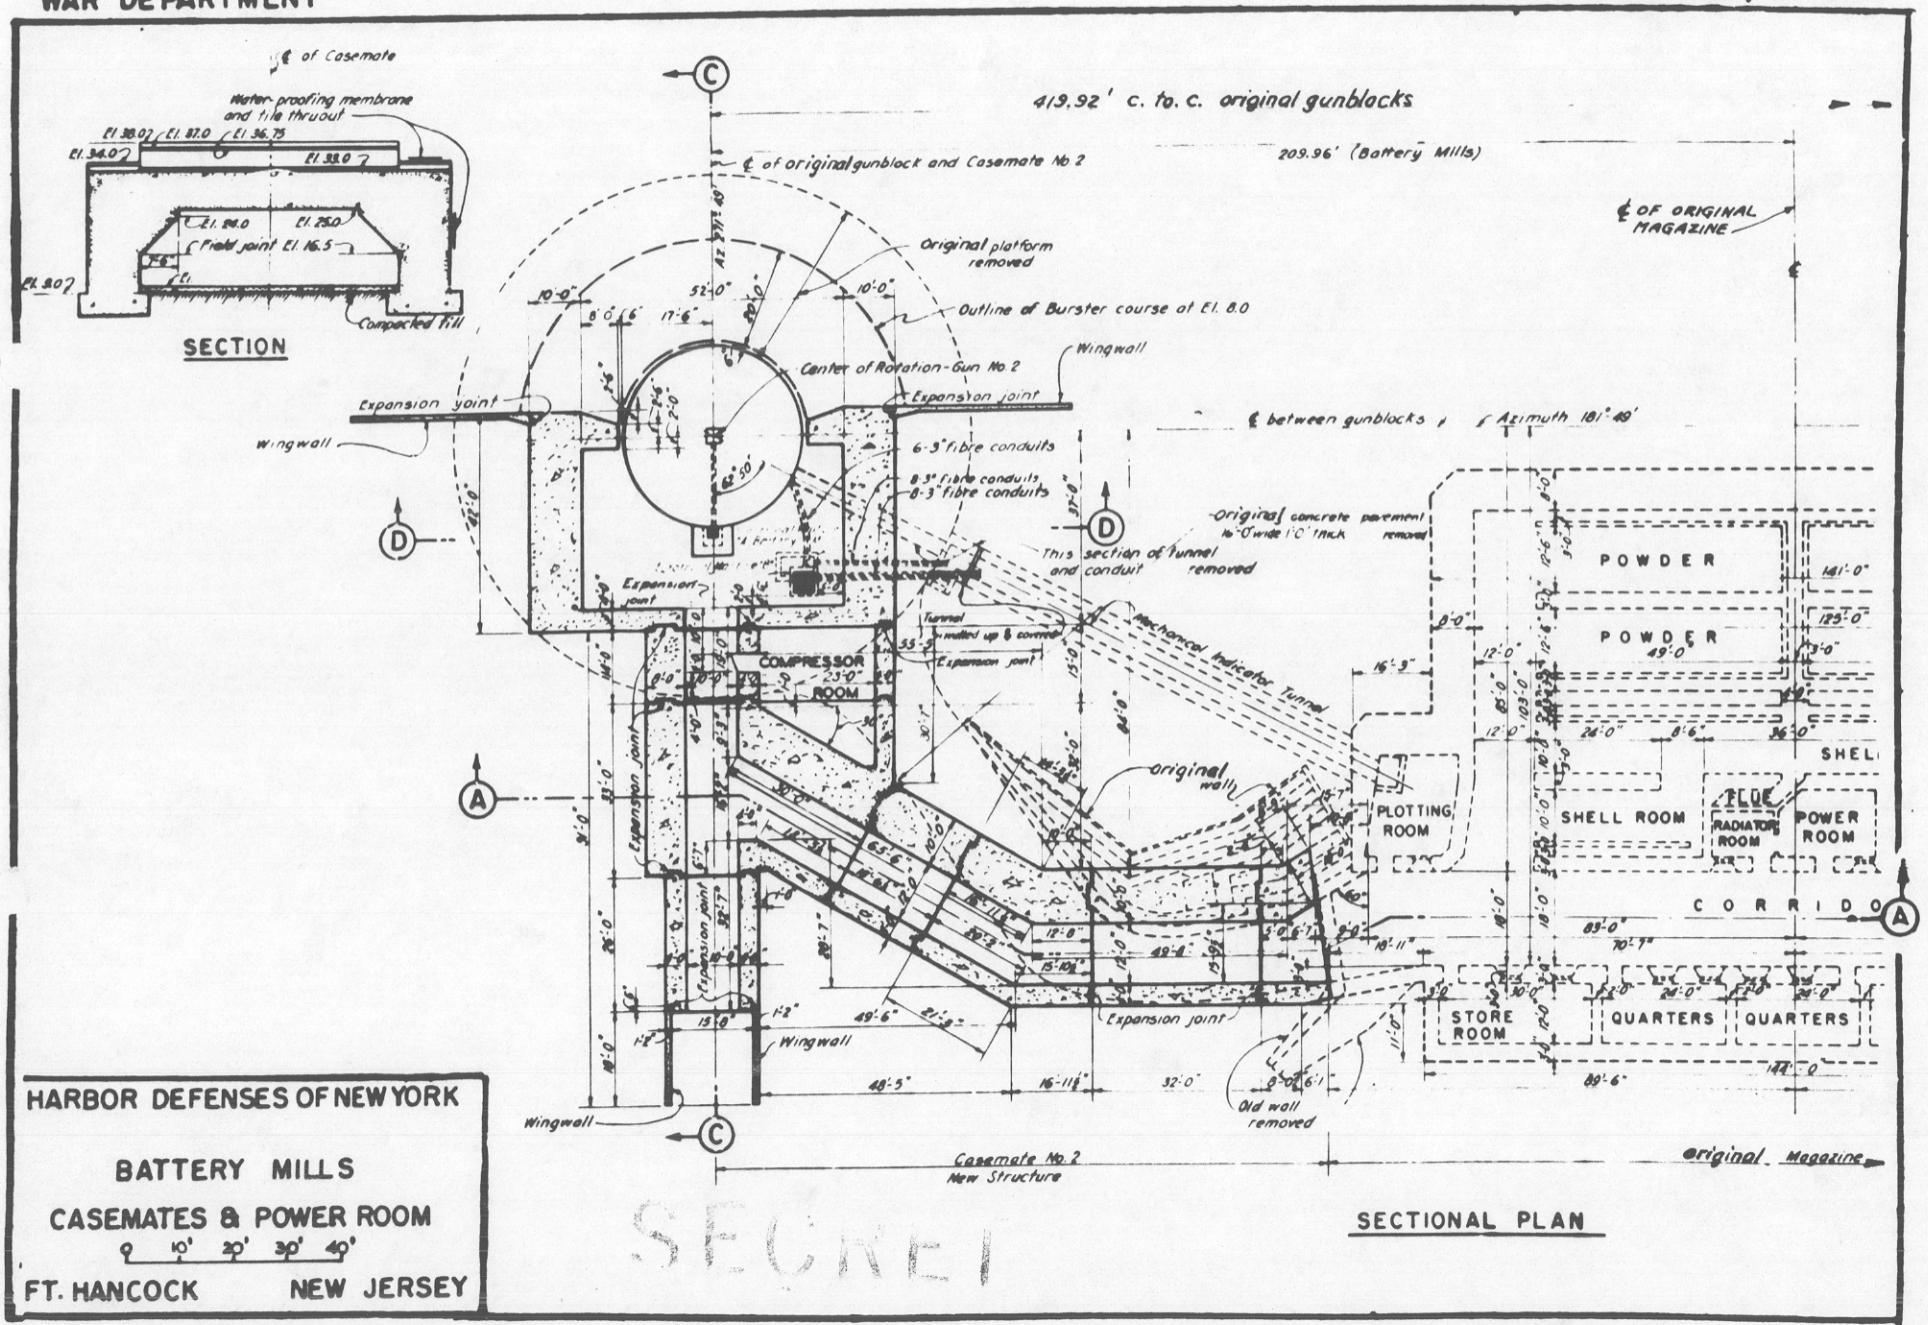

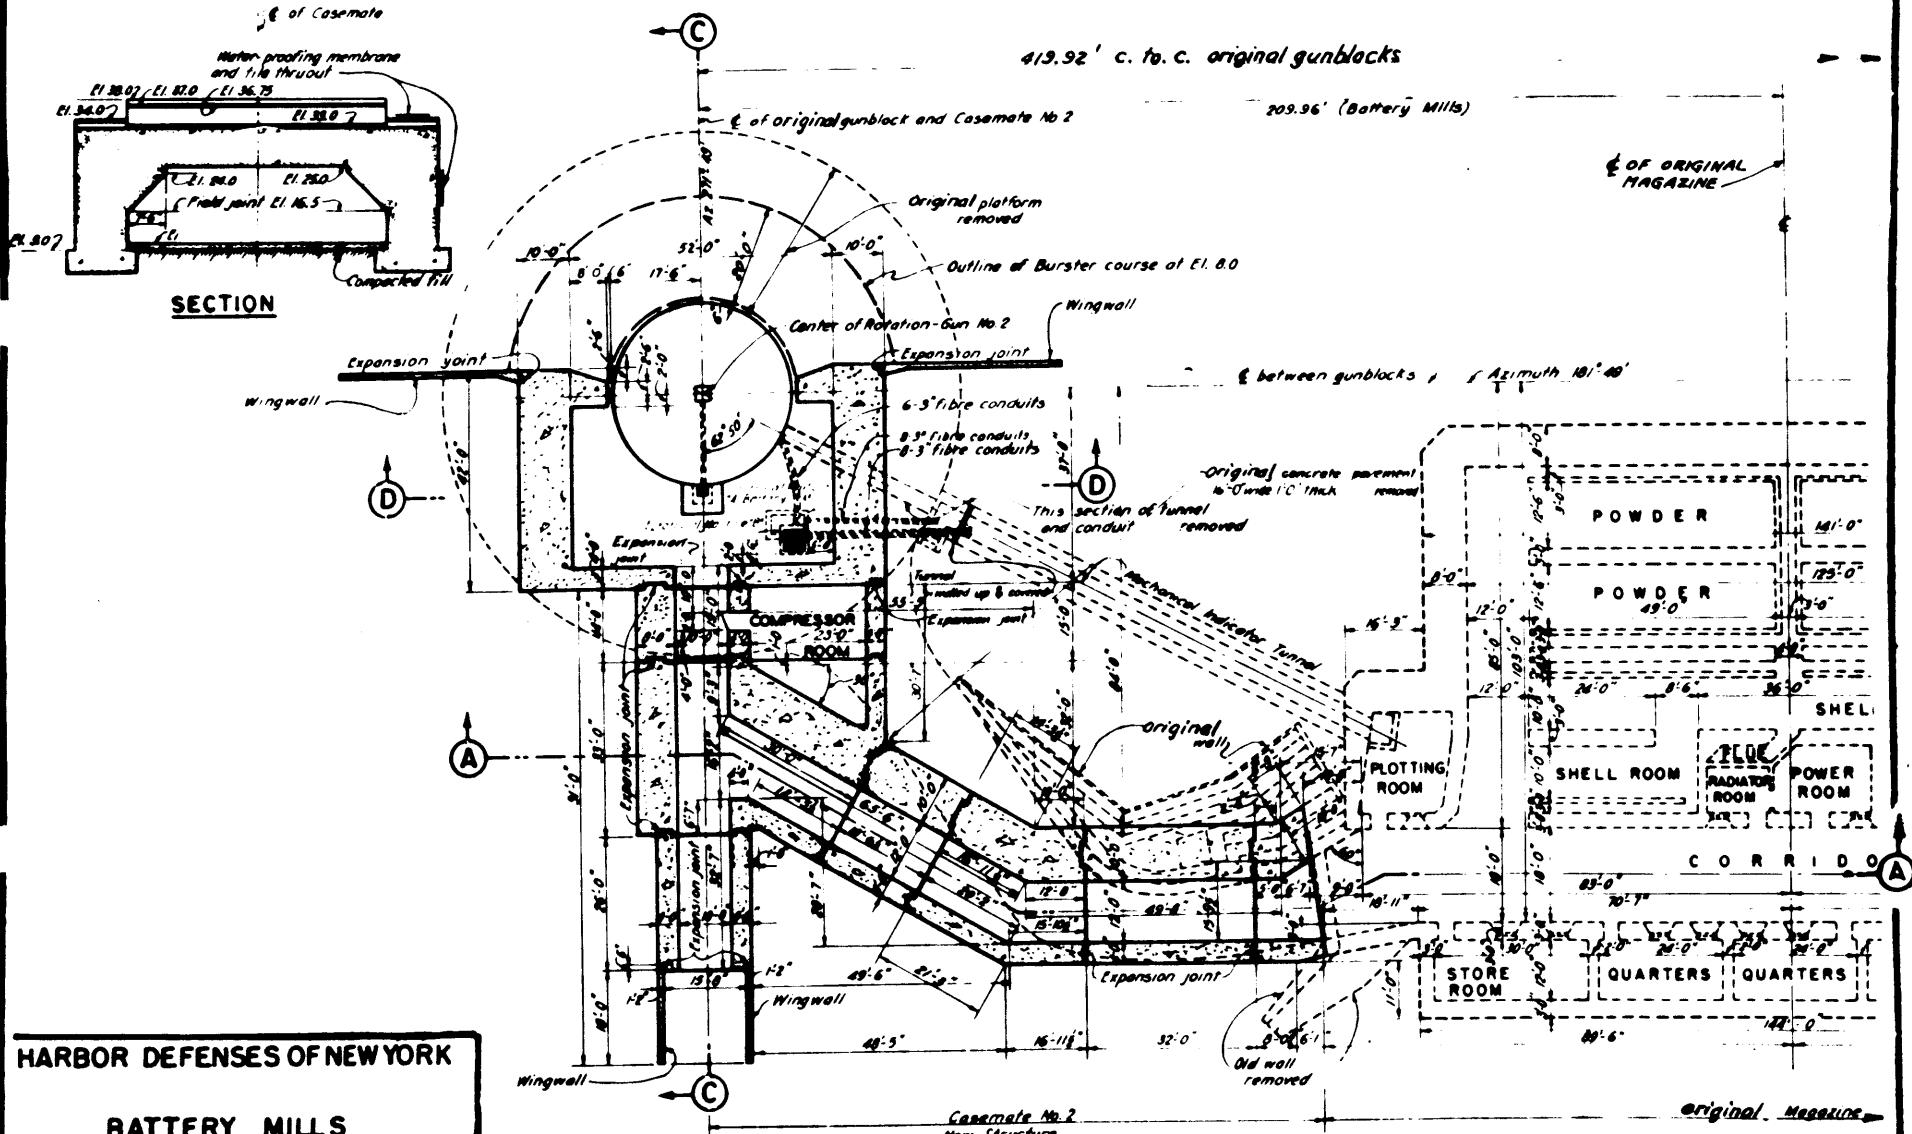

HARBOR DEFENSES OF NEW YORK

BATTERY MILLS


CASEMATES & POWER ROOM

0' 10' 20' 30' 40'

FT. HANCOCK **NEW JERSEY**

WAR DEPARTMENT

CORPS OF ENGINEERS, U.S. ARMY

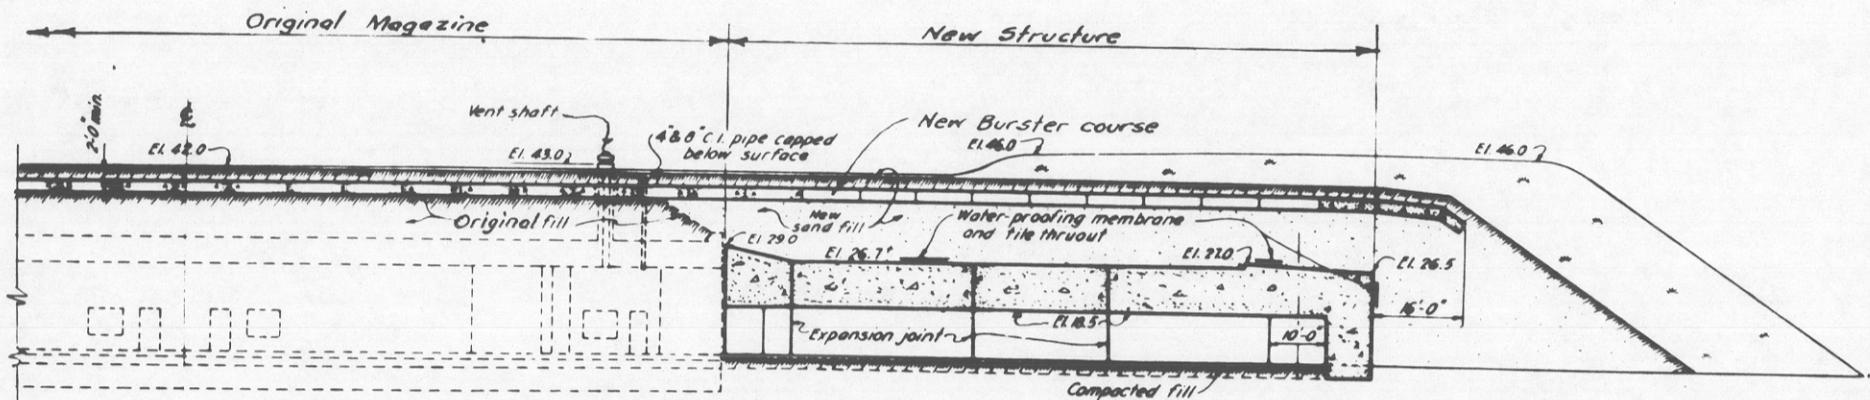

SECTION A-AON C OF CORRIDOR

SECTION A-AON C


HARBOR DEFENSES OF NEW YORK

BATTERY MILLS
CASEMATES & POWER ROOM

0 15' 30'

FT. HANCOCK

NEW JERSEY

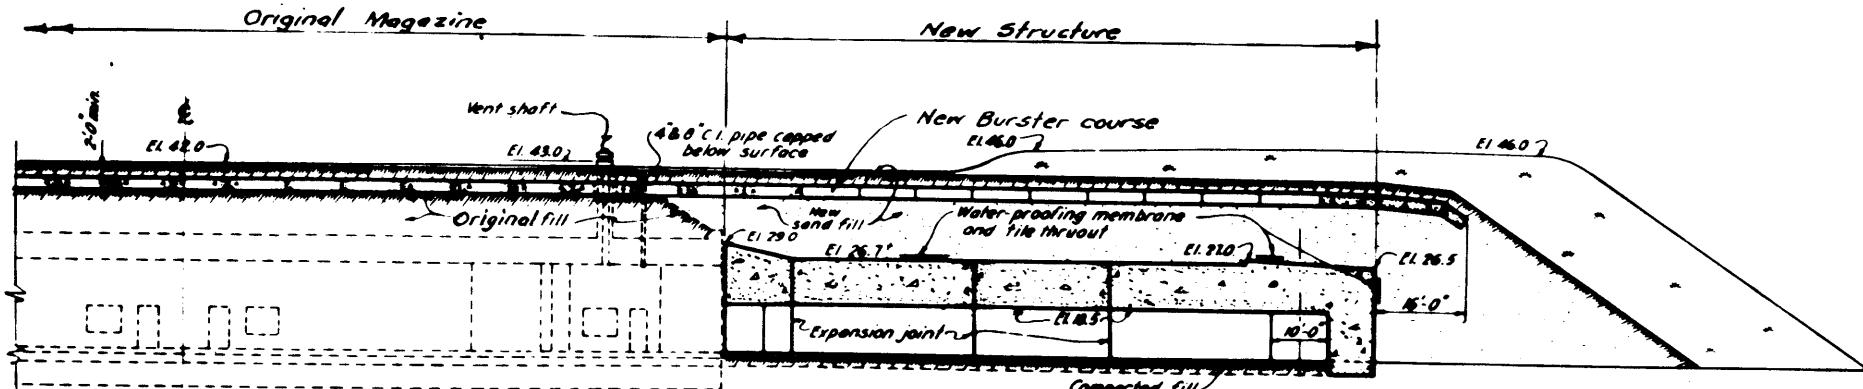SECTION A-AON & OF CORRIDOR

HARBOR DEFENSES OF NEW YORK

BATTERY MILLS

CASEMATES & POWER ROOM


0 15' 30'

FT. HANCOCK

NEW JERSEY

WAR DEPARTMENT

CORPS OF ENGINEERS, U.S.ARMY

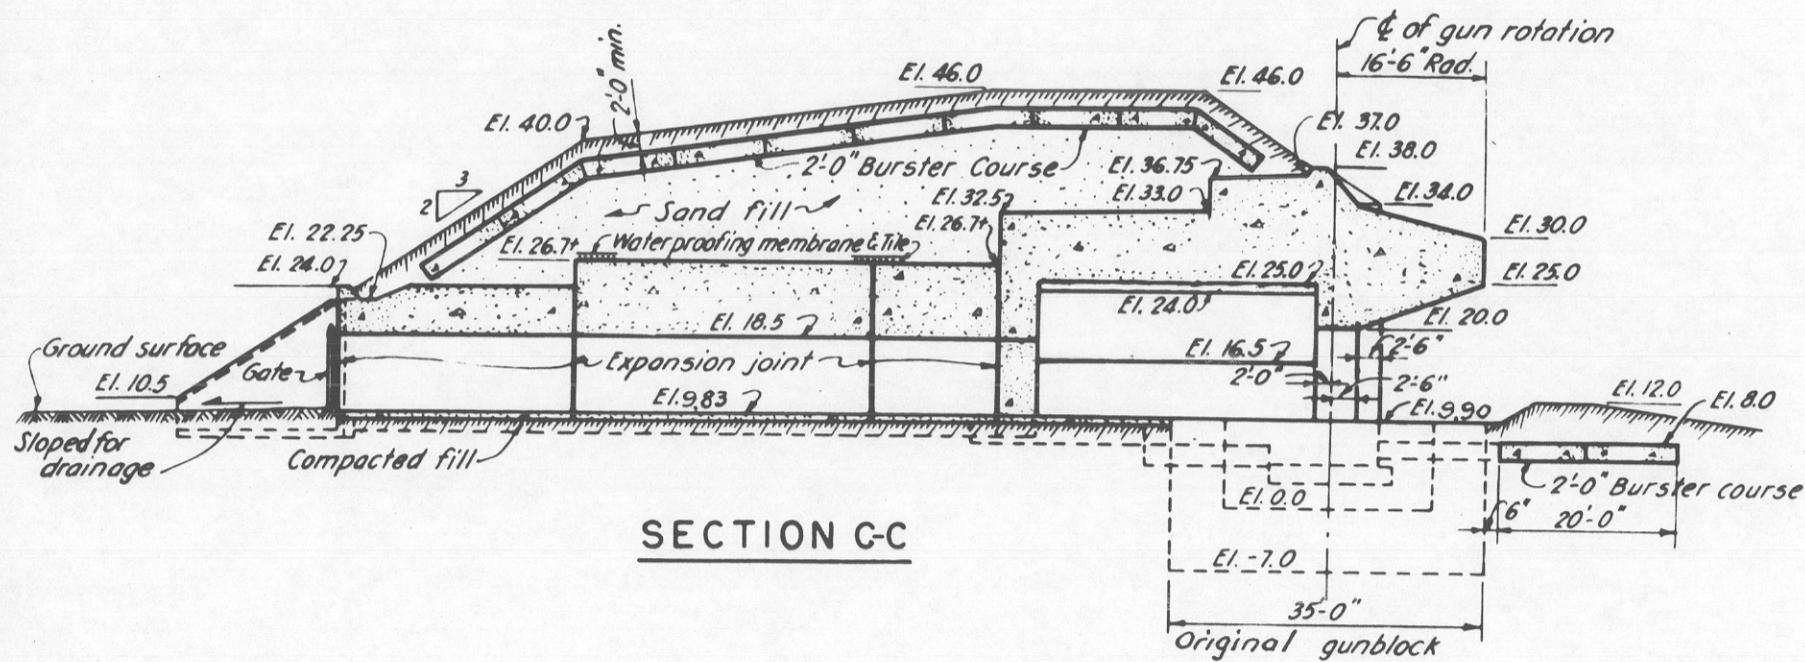

SECTION C-C

HARBOR DEFENSES OF NEW YORK

BATTERY MILLS

CASEMATES & POWER ROOM


FT. HANCOCK

NEW JERSEY

Stecklin

WAR DEPARTMENT

CORPS OF ENGINEERS, U.S.ARMY

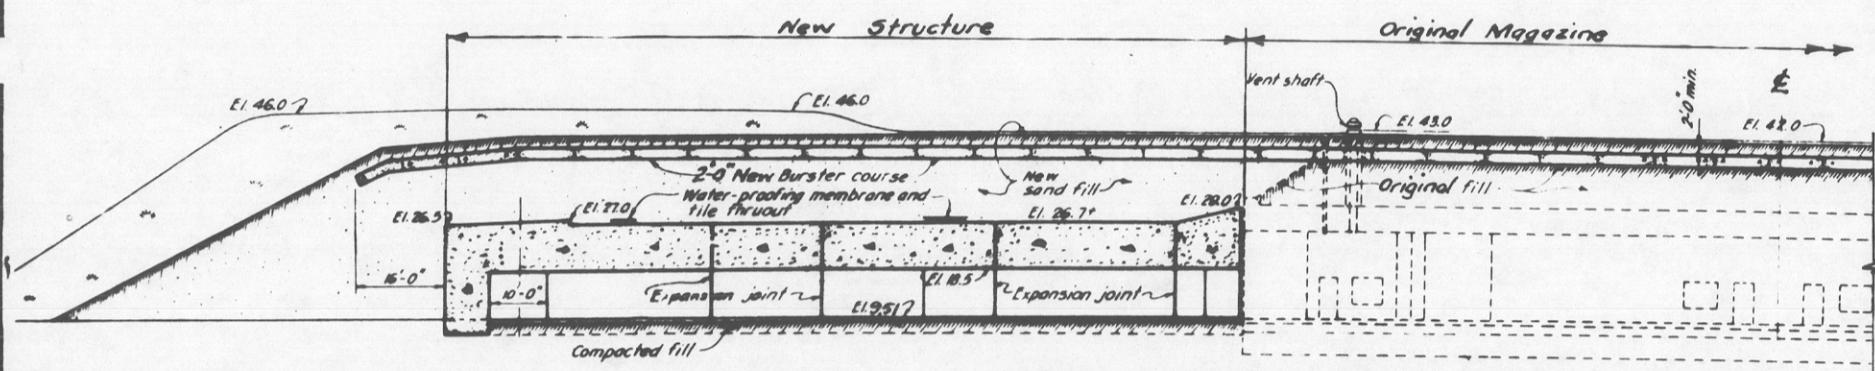

SECTION A-A ON C OF CORRIDOR


HARBOR DEFENSES OF NEW YORK

BATTERY MILLS

CASE MATES & POWER ROOM

FT. HANCOCK

NEW JERSEY

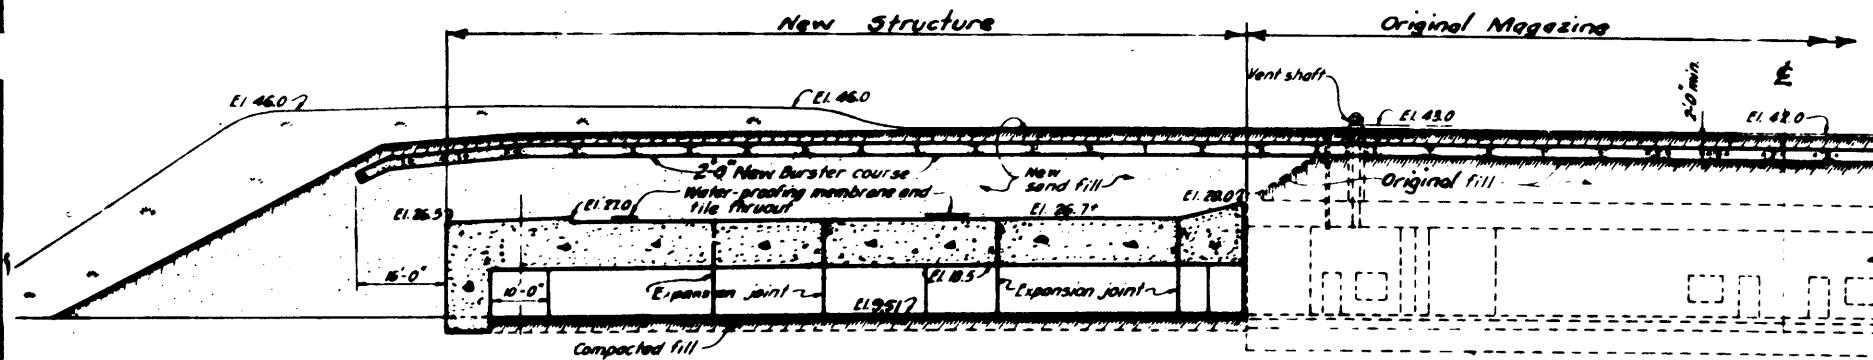

SECTION A-A ON ⌂ OF CORRIDOR

HARBOR DEFENSES OF NEW YORK


BATTERY MILLS

CASEMATES & POWER ROOM

0 10' 20'

FT. HANCOCK

NEW JERSEY

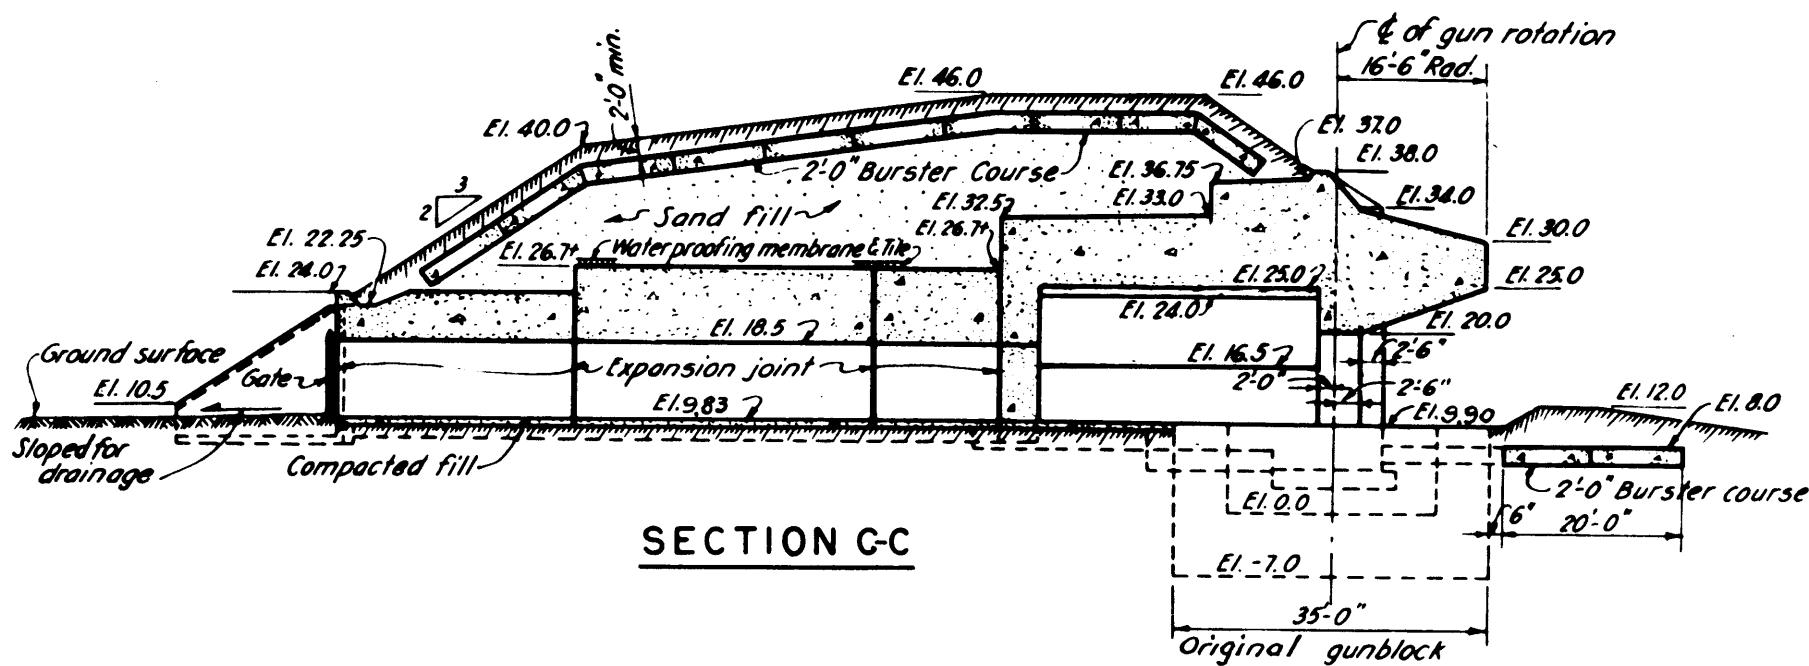

HARBOR DEFENSES OF NEW YORK

BATTERY MILLS


CASEMATES & POWER ROOM
8' 2P' 4P'

FT. HANCOCK

NEW JERSEY

WAR DEPARTMENT

CORPS OF ENGINEERS, U.S.ARMY

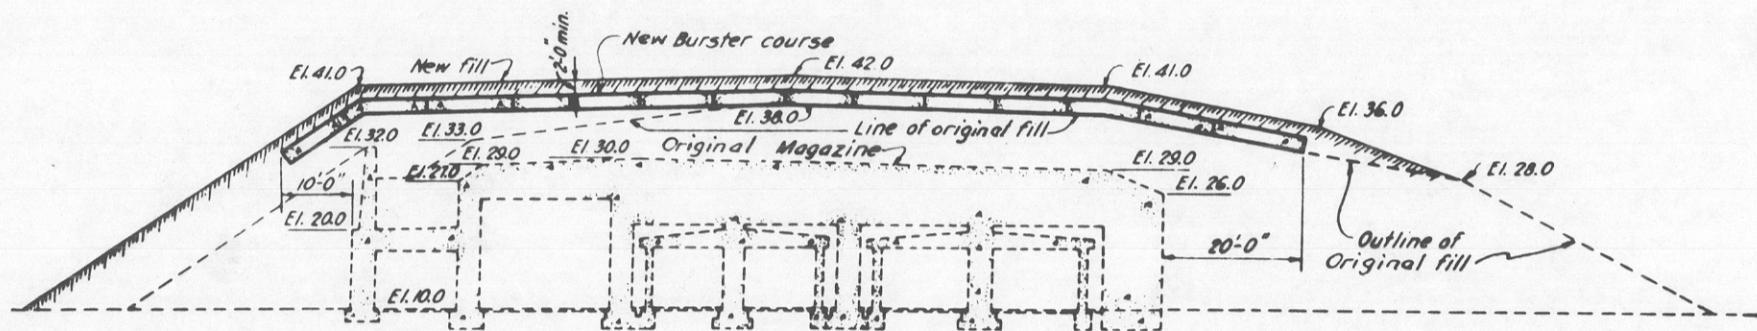

SECTION B-B


ORIGINAL MAGAZINE

SECRET

HARBOR DEFENSES OF NEW YORK

BATTERY MILLS
CASEMATES & POWER ROOM

0 20' 40'
FT. HANCOCK NEW JERSEY

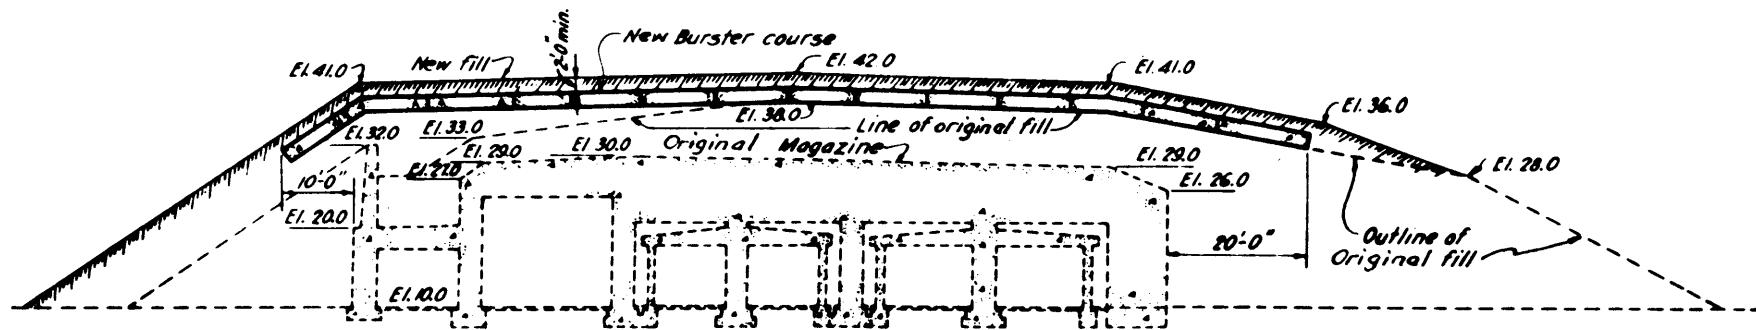

SECTION B-B

ORIGINAL MAGAZINE

HARBOR DEFENSES OF NEW YORK

BATTERY MILLS

CASEMATES & POWER ROOM


0 20' 40'

FT. HANCOCK

NEW JERSEY

WAR DEPARTMENT

CORPS OF ENGINEERS, U.S. ARMY

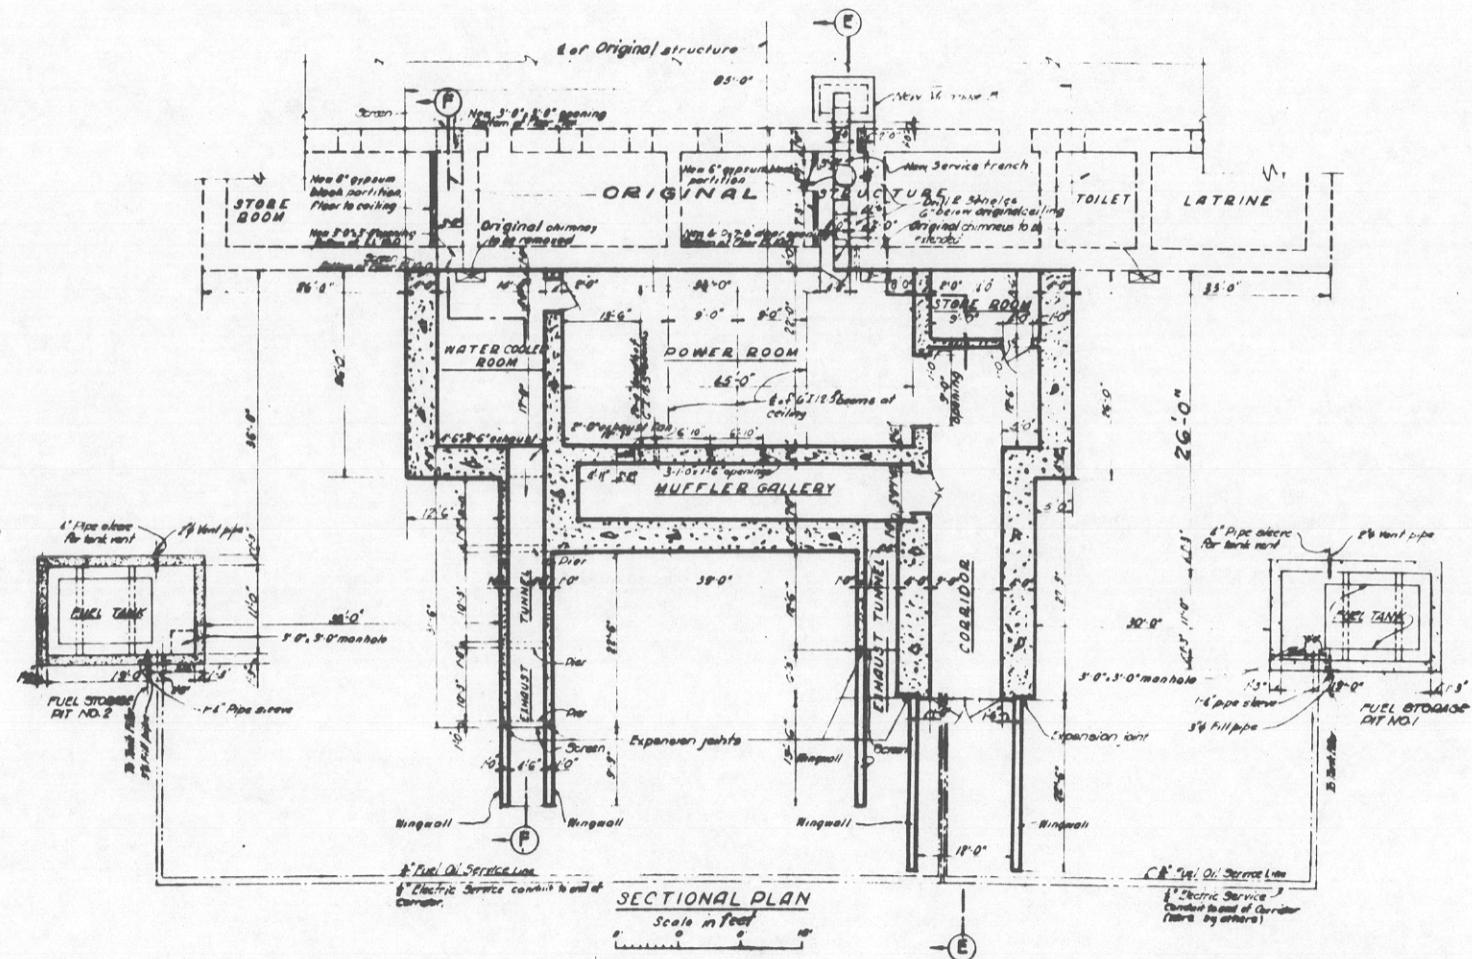


HARBOR DEFENSES OF NEW YORK

**BATTERY MILLS
POWER ROOM**

FT. HANCOCK

NEW JERSEY

SECRET

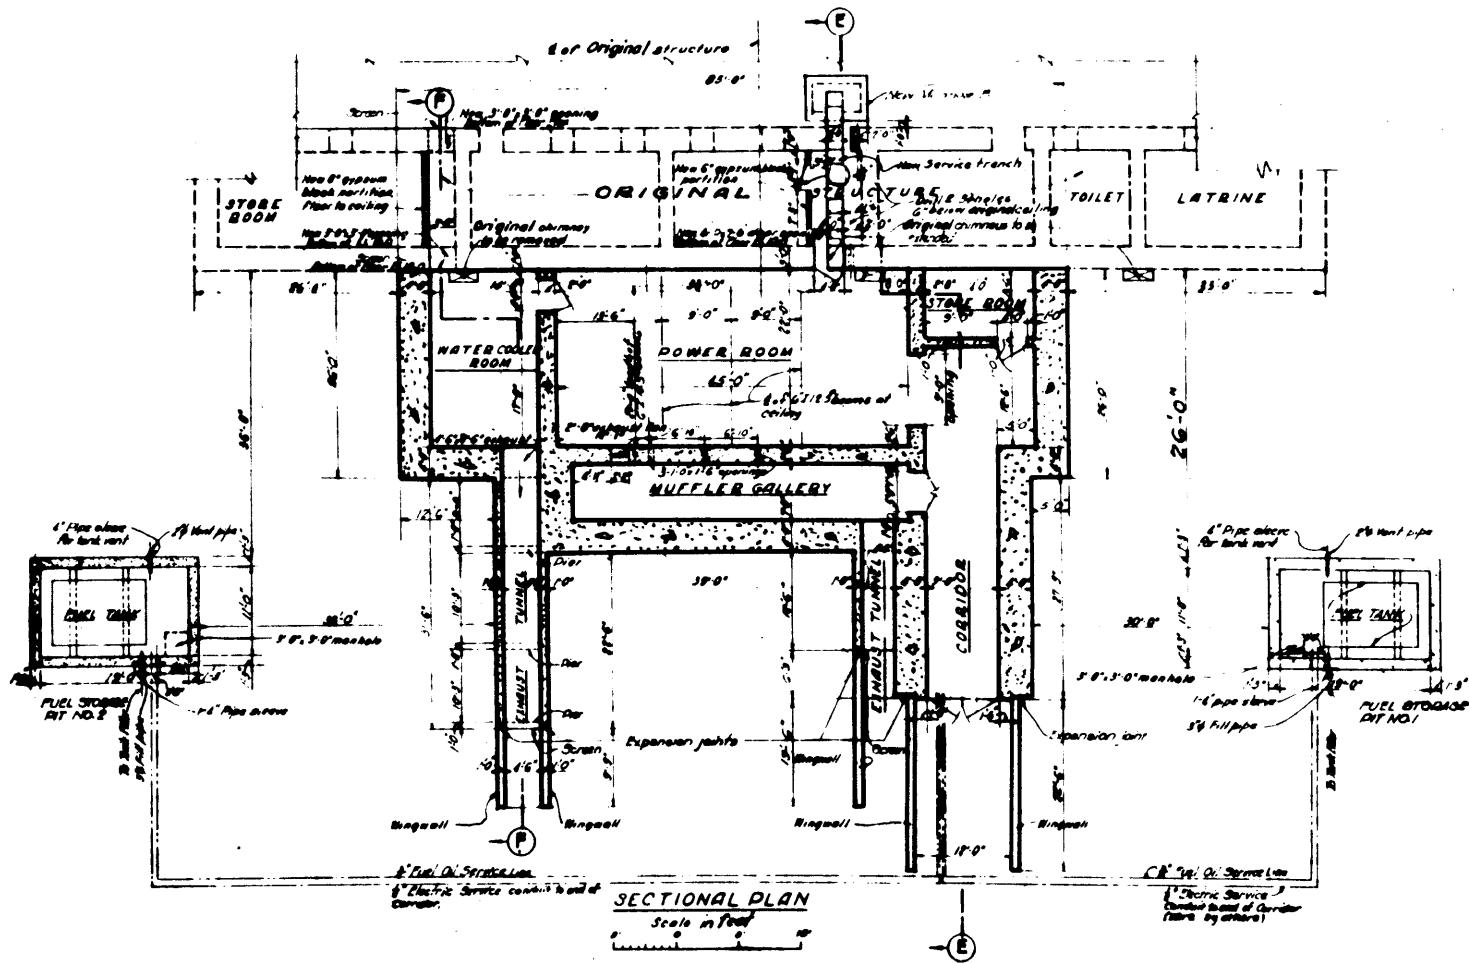



HARBOR DEFENSES OF NEW YORK

**BATTERY MILLS
POWER ROOM**

FT. HANCOCK **NEW JERSEY**

WAR DEPARTMENT

CORPS OF ENGINEERS, U.S.ARMY

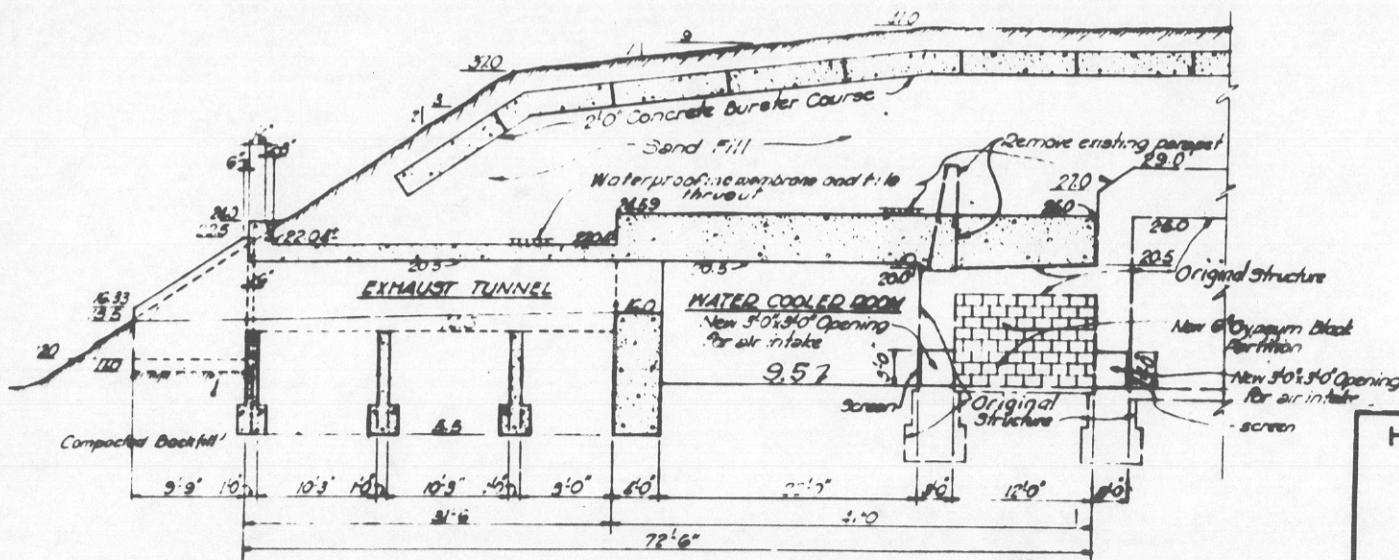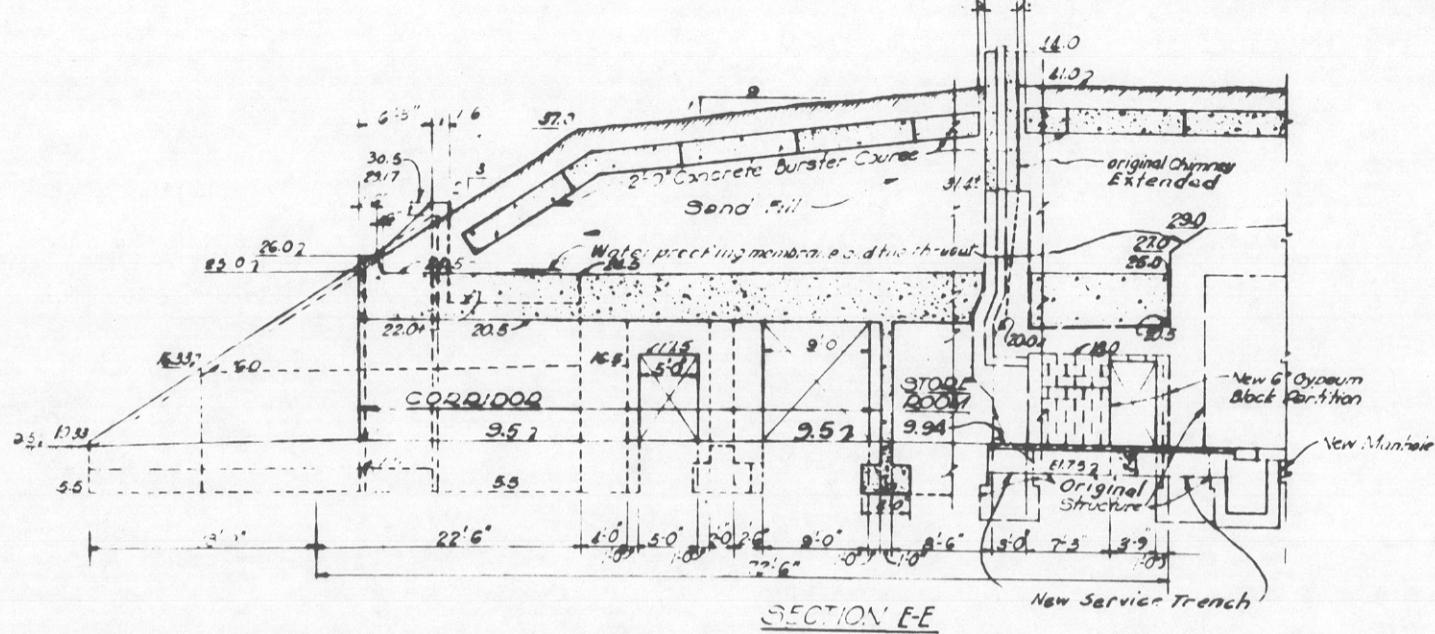



HARBOR DEFENSES OF NEW YORK

BATTERY MILLS
POWER ROOM

FT. HANCOCK

NEW JERSEY

SECRET

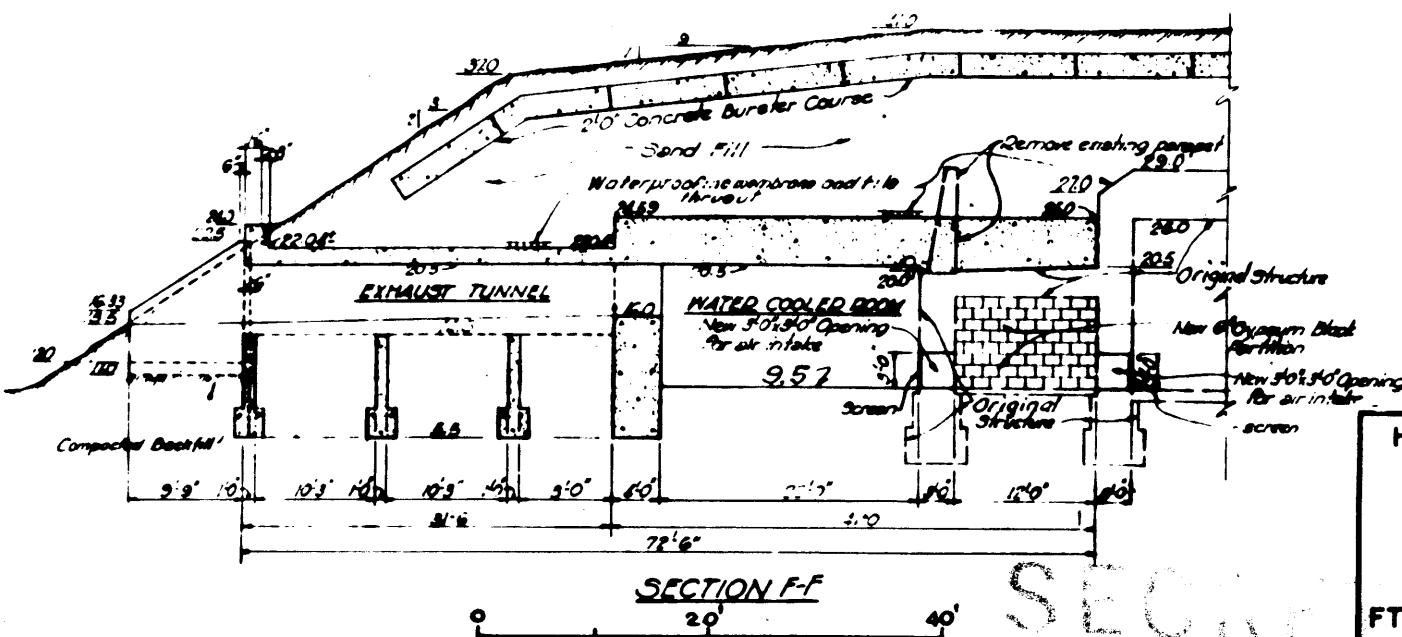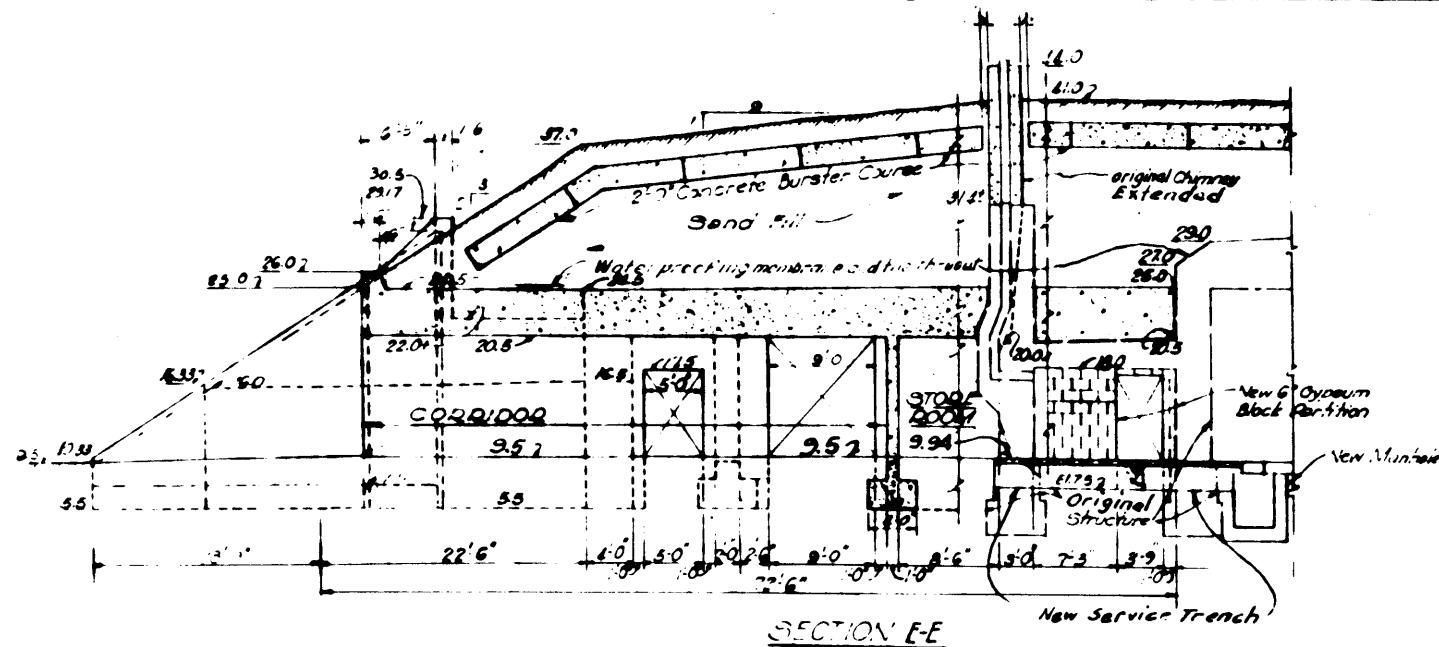

HARBOR DEFENSES OF NEW YORK


**BATTERY MILLS
POWER ROOM**

FT. HANCOCK

NEW JERSEY

WAR DEPARTMENT

CORPS OF ENGINEERS, U.S.ARMY

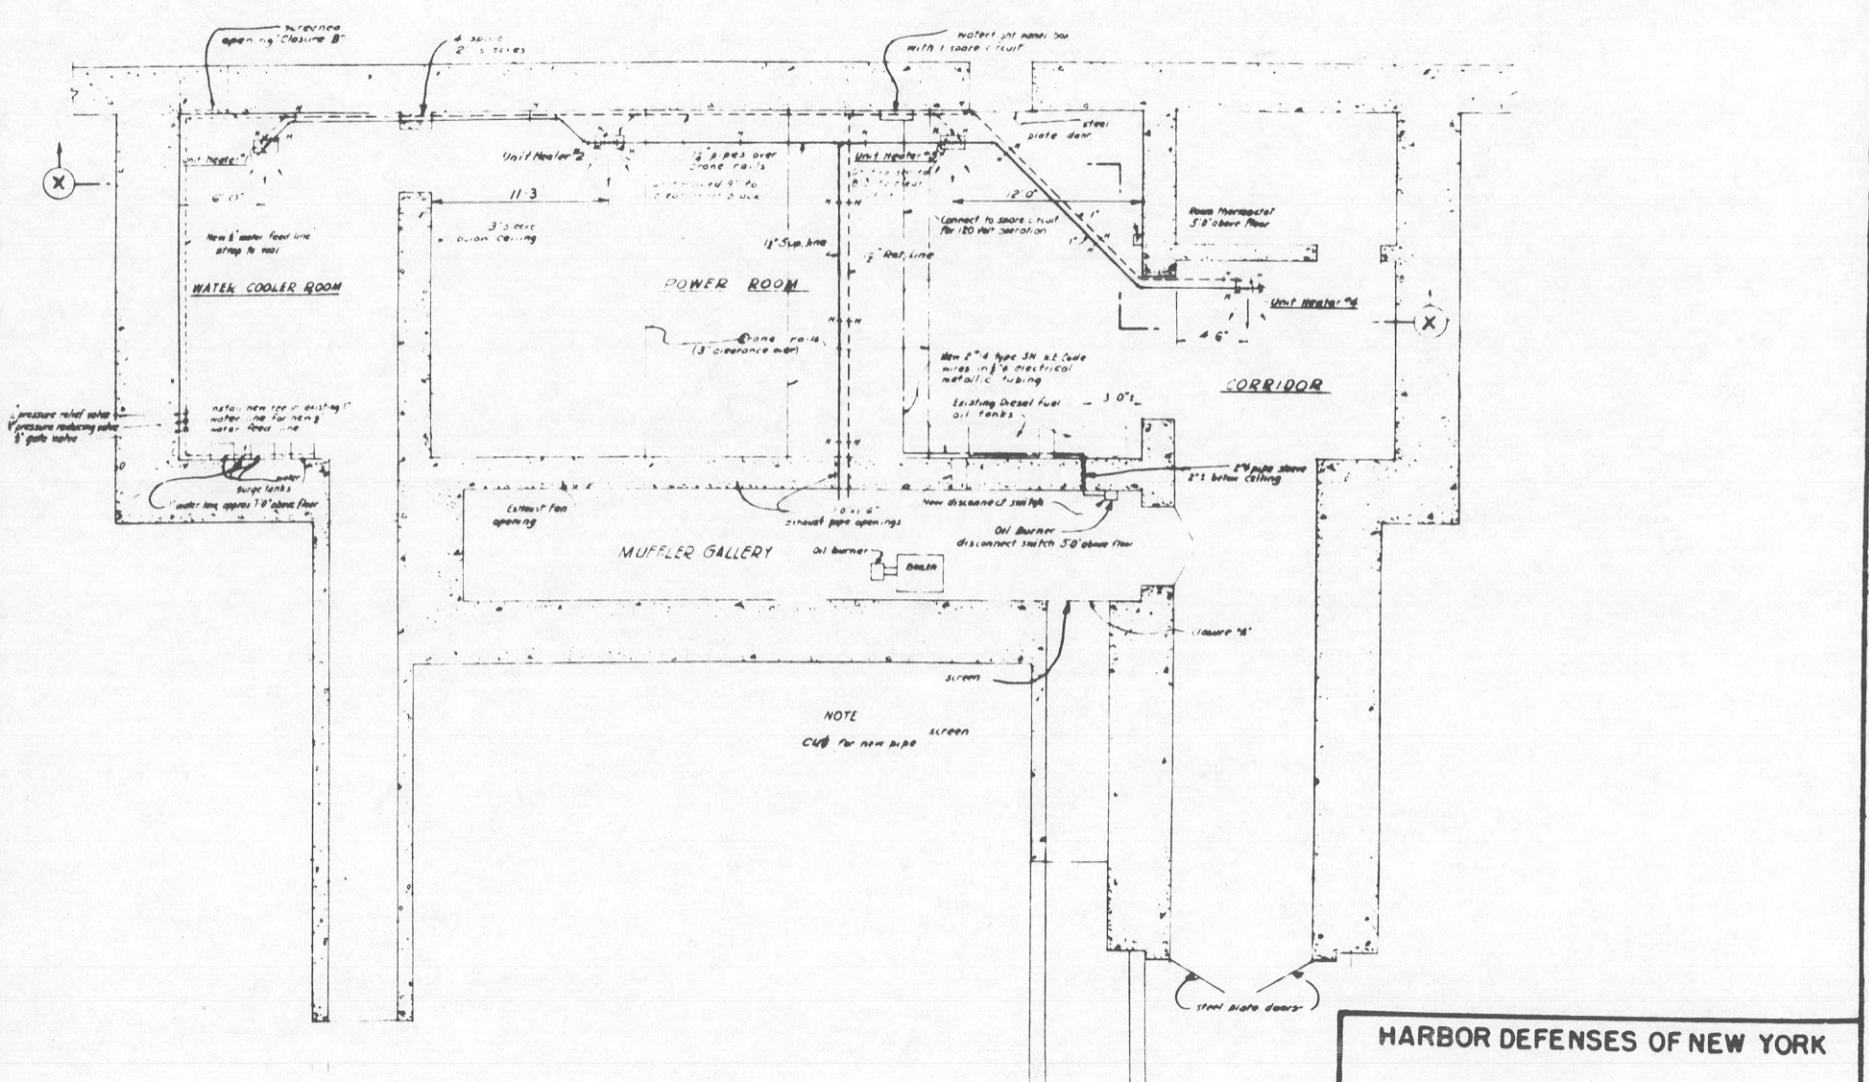

HARBOR DEFENSES OF NEW YORK


BATTERY MILLS

POWER ROOM HEATING SYSTEM

0 6' 12' 18' 24'

FORT HANCOCK

NEW JERSEY

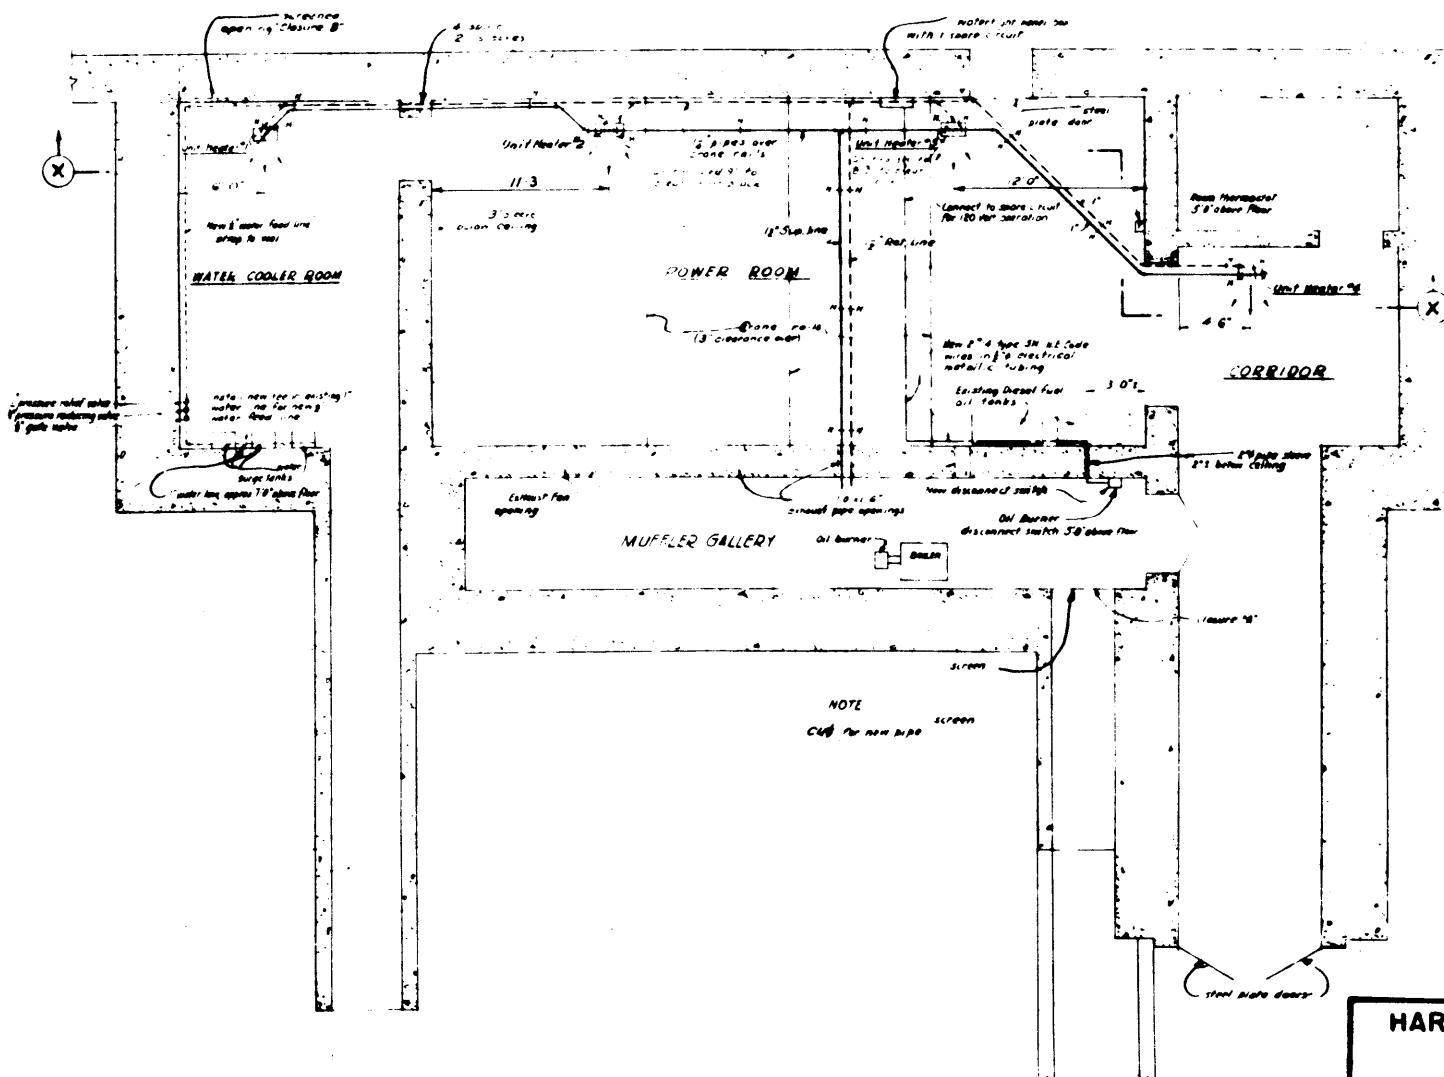

HARBOR DEFENSES OF NEW YORK

BATTERY MILLS

POWER ROOM HEATING SYSTEM


0 6' 12' 18' 24'

FORT HANCOCK

NEW JERSEY

WAR DEPARTMENT

CORPS OF ENGINEERS, U.S.ARMY

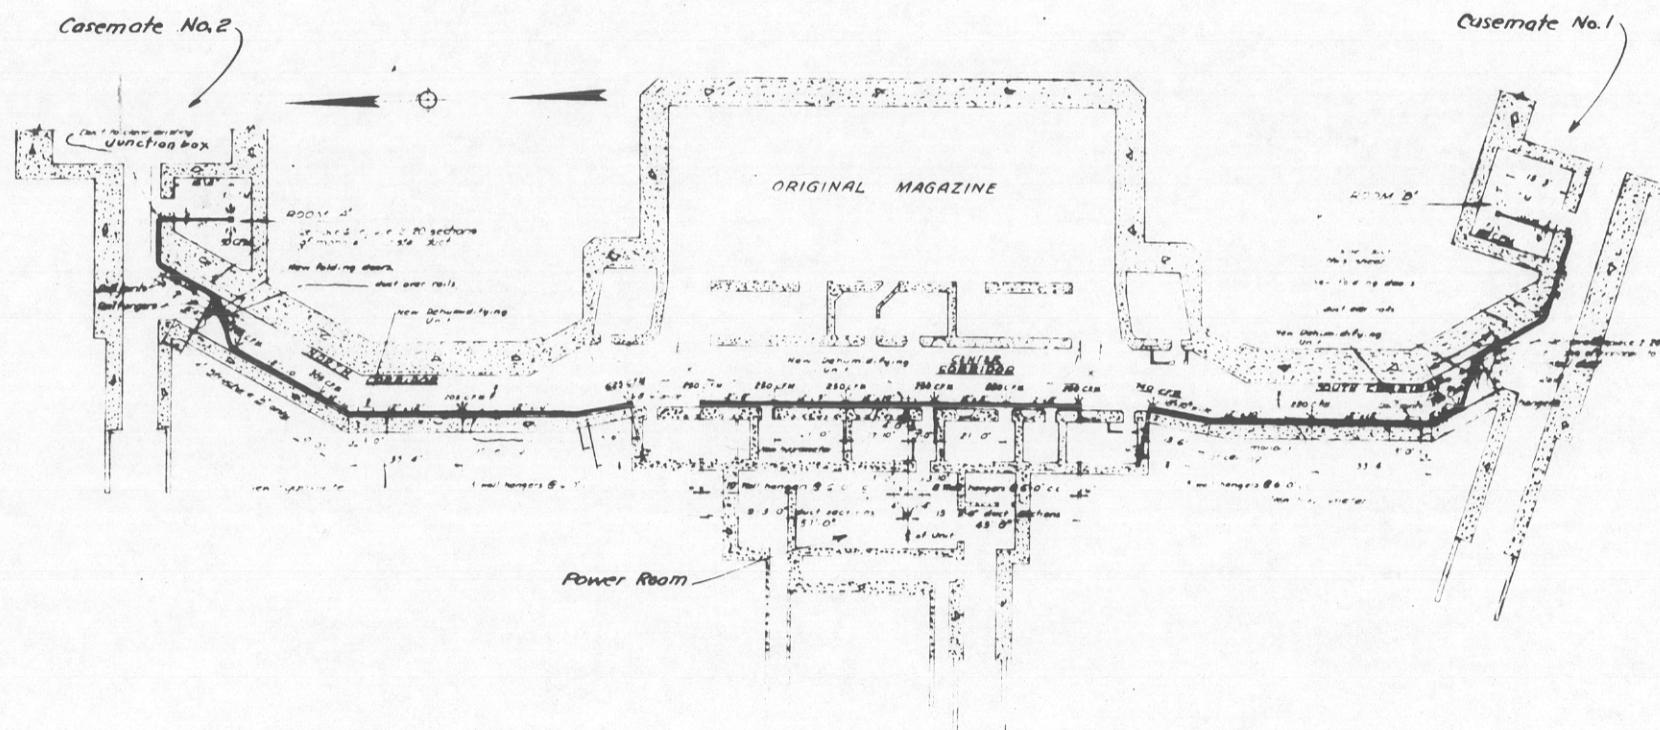

PLAN

HARBOR DEFENSES OF NEW YORK

BATTERY MILLS


ADDITIONAL DEHUMIDIFYING SYSTEM

0' 15' 30' 45'

FT. HANCOCK

NEW JERSEY

~~SECRET~~

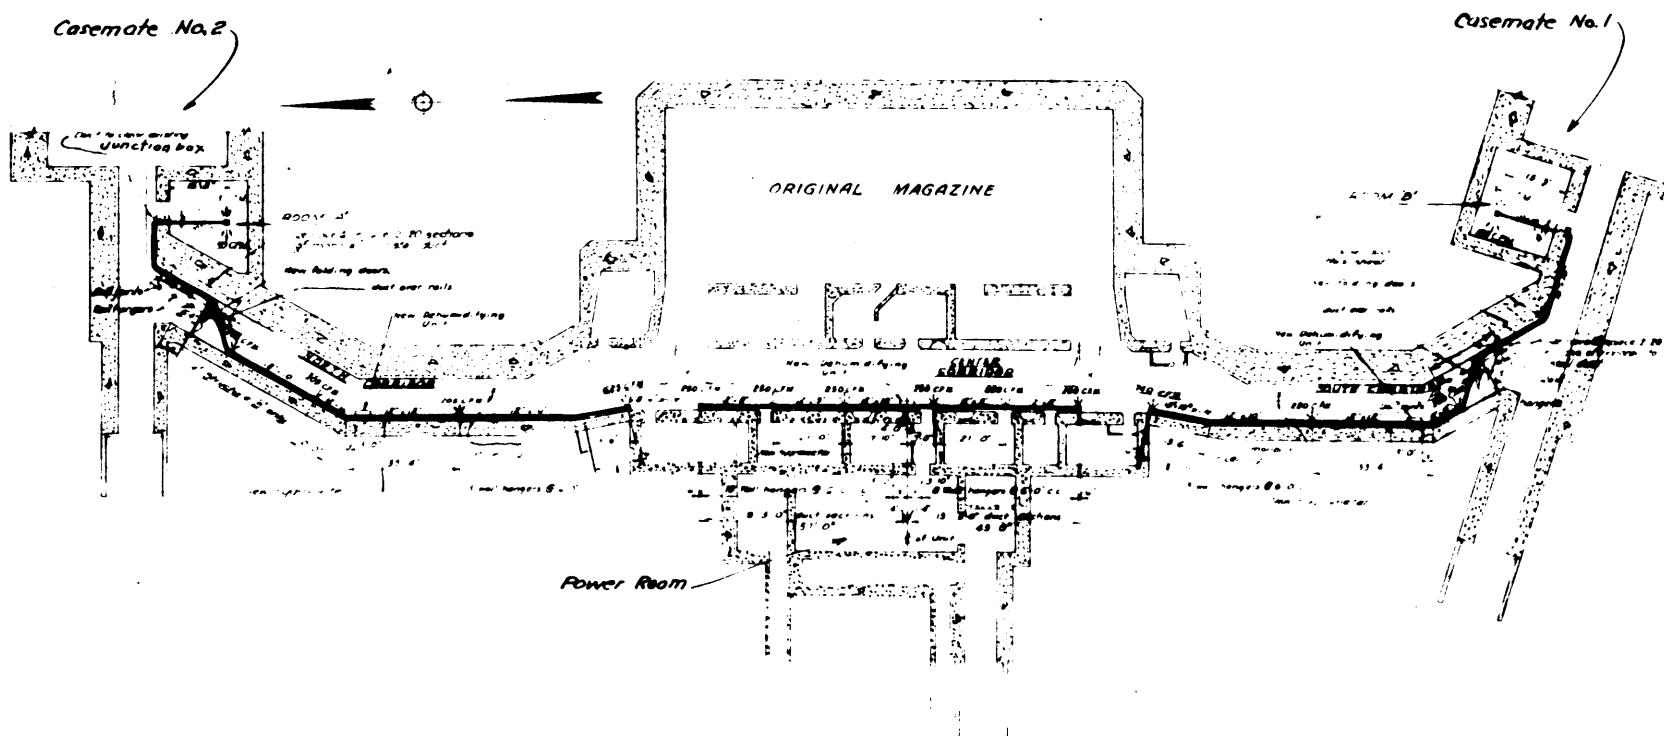PLAN

HARBOR DEFENSES OF NEW YORK

BATTERY MILLS

ADDITIONAL DEHUMIDIFYING SYSTEM

0 15' 30' 45'

FT. HANCOCK

NEW JERSEY